
FORM 51 25M 8-50 WESTERN Rooks **KANSAS**

Section 19 Township 9 Range 19W

Well No. #3 Dan Barry (C)

Company Continental Oil Co.

2

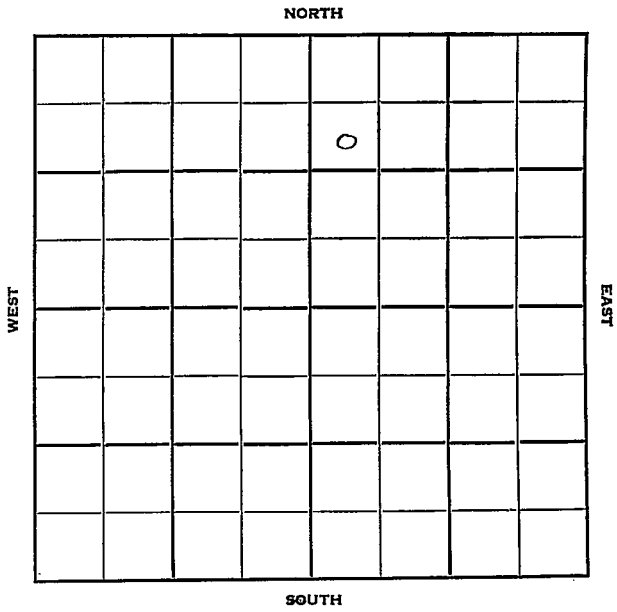

FORM 252-B
10M 11-50 PETROL

Rooks KANSAS

Sec. 10 Twp. 9 R. 19W

Well No. #3 Dan Barry (C) Farm

Continental Oil Co. Company

Contractor

Barry


990' Ft. from N. Line

Ft. from S. Line

Ft. from E. Line

330' Ft. from W. Line

SW NW NE

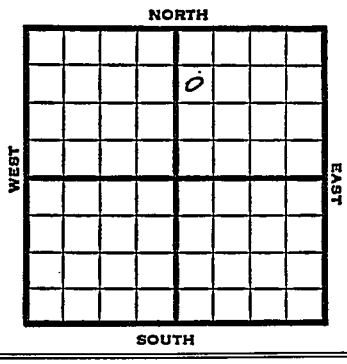

1951	Elev. 2064' REPORT
10/17	Location RUR
11/21	Spud 10-19-51 Oil well T[D] 3484' 10" @ 196 Heeb 3180' Lans. 3219' Arb. 3465' TD 3471' 5" @ 3467' DD 3478' FU 2600' oil. DD 3484' S/40 BOPH 4 hr. S/500 BO 12 hr. Comp. 3000 BOPD COMPLETED

FORM 275 FOR SALE BY KANSAS BLUE PRINT CO.

County Rooks State Kansas

Sec. 10 (Blk. Twp.) 9 (Sur. Rge.) 19W Map No.

Operator Continental Oil Co.

Well No. 3 Farm Dan Barry (C)

Elev. Location SW NW NE

FIRST REPORT

990 Ft. From N Line NE

330 Ft. From W Line Quarter

1st. Report OCT 17 1951

Completion

Remarks

Spudding Date

Drlg. Data Barry

Location RUR

J. E. TYRA

FORM 275 FOR SALE BY KANSAS BLUE PRINT CO.


County Rooks State Kansas

Sec. 10 (Blk. Twp.) 9 (Sur. Rge.) 19W Map No.

Operator Continental Oil

Well No. 3 Farm Dan Barry "C"

Elev. 2064 Location SW NW NE

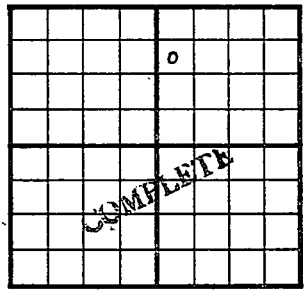

990 Ft. From N Line NE

330 Ft. From W Line Quarter

1st. Report

Completion NOV 21 1951

Remarks Barry Pool

Spudding Date 10-19-51

Drlg. Data Oil well TD 3484

10" @ 196 Heeb. 3180 Lans. 3219

Arb. 3465 TD 3471 5" @ 3467 DD 3478

FU 2600' oil DD 3484 S/ 40 boph 4 hr.

S/ 500 bo 12 hr. Comp. 3000 bopd

J. E. TYRA