


Section 10 Township 9 Range 21W

Well No. #2 E. Clark CLACK

Company Continental etal

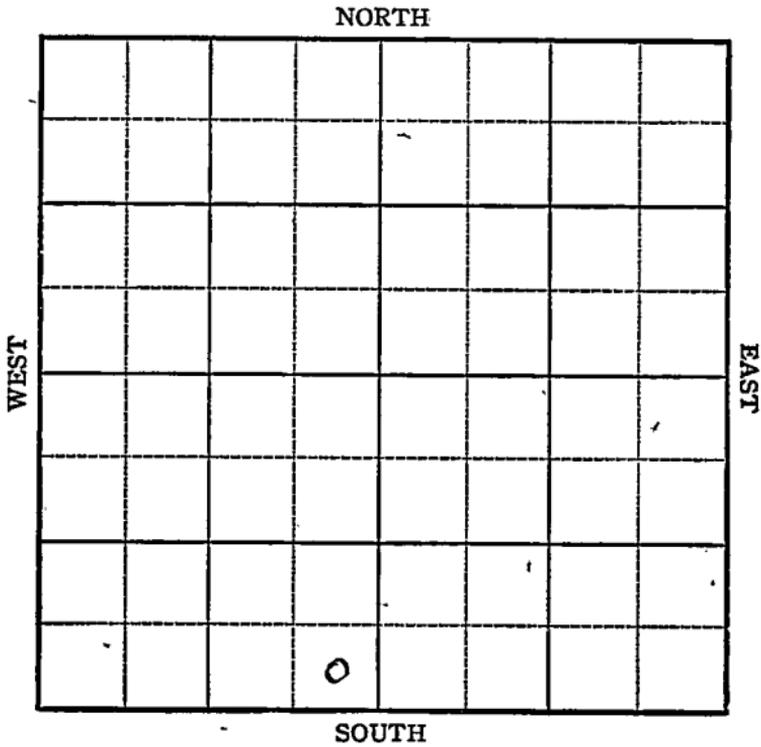

Sec. 10 Twp. 9 R. 21-W

Well No. #2 E. Clark CLACK Farm

Continental etal Company


\_\_\_\_\_ Ft. from N. Line

330 Ft. from S. Line

330 Ft. from E. Line

\_\_\_\_\_ Ft. from W. Line

*Elev. 2203*

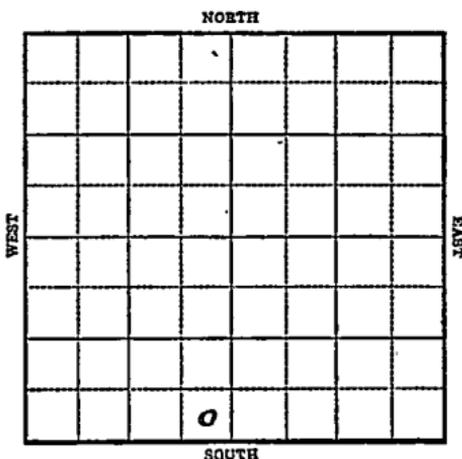

1944

R E P O R T

2/2	Derrick
2/8	10" @ 241 WOC.
2/15	Drlg. 1840'
2/23	Drlg. 3310'
3/1	Arb 3663-84 TD 6" @ 3664 Rust
3/8	"
3/16	"
3/22	Lans 3365 SSO 3459-66 3554-62 TD 3684 Rust
3/29	" " "
4/5	Td 3688 Swb 260 oil in 18 hrs.
4/12	1000 acid -
4/19	" 2

OVER

1944

4/26

6" @ 3664

Arb 3663

TD 3688

1000 acid

Pump 812 Pot. '

Gravity 31

**COMPLETED**

**KANSAS**

Map No. 60 Sec. 10 Twp. 9 R. 21W

Well No. 2 E., Clark


Continental etal. Company

FIRST REPORT Contractor

SE SW

**SECTION PLAT**

\_\_\_\_\_ Ft. from N. Line  
330 Ft. from S. Line  
330 Ft. from E. Line  
 \_\_\_\_\_ Ft. from W. Line

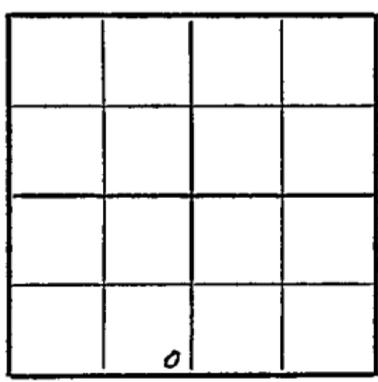

Morel Pool

Location \_\_\_\_\_  
 Rig up \_\_\_\_\_  
 Drilling and Remarks:

**Derrick**

**RECORD**

Cased \_\_\_\_\_ in., \_\_\_\_\_ ft.  
 Sand \_\_\_\_\_  
 Gas \_\_\_\_\_  
 Oil \_\_\_\_\_  
 Total Depth \_\_\_\_\_

**PRODUCTION**

1st 24 hrs. Nat. \_\_\_\_\_  
 1st 24 hrs. after shot \_\_\_\_\_  
 Gas \_\_\_\_\_ Cu. Ft.  
 Dry Hole \_\_\_\_\_  
 Abandoned \_\_\_\_\_

Date  
FEB 2 1944 1944

**S. J. LEWIS** Scout

Map No. KANSAS Sec. 10 Twp. 9 R. 21W

Well No. 2 Clack

Continental etal. Company

CORRECTION Contractor

SE SW

SECTION PLAT

\_\_\_\_\_ Ft. from N. Line

330

\_\_\_\_\_ Ft. from S. Line

330

\_\_\_\_\_ Ft. from E. Line

\_\_\_\_\_ Ft. from W. Line


Morel Pool

Location \_\_\_\_\_

Rig up \_\_\_\_\_

Drilling and Remarks:

Reported #2  
Clark

RECORD

Cased \_\_\_\_\_ in., \_\_\_\_\_ ft.

Sand \_\_\_\_\_

Gas \_\_\_\_\_

Oil \_\_\_\_\_

Total Depth \_\_\_\_\_

PRODUCTION

1st 24 hrs. Nat. \_\_\_\_\_

1st 24 hrs. after shot \_\_\_\_\_

Gas \_\_\_\_\_ Cu. Ft.

Dry Hole \_\_\_\_\_

Abandoned \_\_\_\_\_

Date

FEB 9 1944 19

S. J. LEWIS  
Scout

**KANSAS**

Pool Name Morel Pool

Map No. 65 Sec. 10 Twp. 9 R. 21W

Well No. 2 Clack

Continental et al. Company

**COMPLETED**

Contractor

SE SW

## SECTION PLAT

\_\_\_\_\_ Ft. from N. Line

330

\_\_\_\_\_ Ft. from S. Line

330

\_\_\_\_\_ Ft. from E. Line

\_\_\_\_\_ Ft. from W. Line


Graham County

## RECORD

Location \_\_\_\_\_

Cased \_\_\_\_\_ in., \_\_\_\_\_ ft.

Rig up \_\_\_\_\_

Sand \_\_\_\_\_

Drilling and Remarks:

Gas \_\_\_\_\_

Oil \_\_\_\_\_

Cor 83663Total Depth 36886" @ 36641000 acidPump 8712 R.Y.810/8

## PRODUCTION

1st 24 hrs. Nat. \_\_\_\_\_

1st 24 hrs. after shot \_\_\_\_\_

Gas \_\_\_\_\_ Cu. Ft.

Dry Hole \_\_\_\_\_

Abandoned \_\_\_\_\_

Date

APR 26 1944 19S. J. LEWIS Scout