

Section 10 Township 9 Range 21W

Well No. 1 Clack "A"

Company Continental

Morel Pool

NORTH

0							

13

WEST

EAST

SOUTH

Sec. 10 Twp. 9 R. 21W ✓

Well No. 1 Clack "A" Farm

Continental Company

Morel Pool


\_\_\_\_\_ Ft. from N. Line

990 Ft. from S. Line

\_\_\_\_\_ Ft. from E. Line

330 Ft. from W. Line

NW SW SW

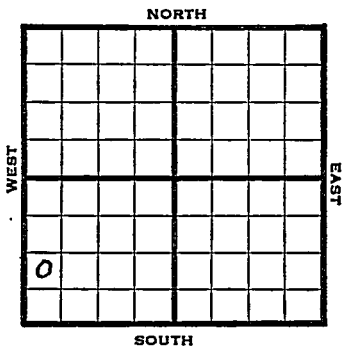

1948

Elev. 2187' REPORT

9/22

10" @ 329  
Drilling 2308'

9/29

Drlg 3551'

10/6

Arb. 3678'  
TD 3688'  
6" @ 3679'  
Swb 23 bbls oil 5 hrs.

10/13

"

10/19

"

10/26

"

11/3

"

11/10

"

11/17

Arbuckle 3678'  
6" @ 3679'  
Pump 558 oil Pot.  
Gr. 30°  
TD 3688'

**COMPLETED**

Graham County Kansas State

Map No. Sec. 10 Twp. 9 R. 21W

Well No. 1 Clack "A"

Continental Company

FIRST REPORT

Contractor

NW SW SW

SECTION PLAT


Ft. from N. Line

990 Ft. from S. Line

Ft. from E. Line

330 Ft. from W. Line

Morel Pool

Remarks:

10" @ 329 drlg. 2308

Date SEP 22 1948

Scout S. J. LEWIS

