

Graham

KANSAS

Sec. 10 Twp. 9 R. 21 W

Well No. # 2 E. Clack "A" Farm

Continental Oil Company

Contractor

Morel Pool

Ft. from N. Line

330


Ft. from S. Line

Ft. from E. Line

990

Ft. from W. Line

SE SW SW

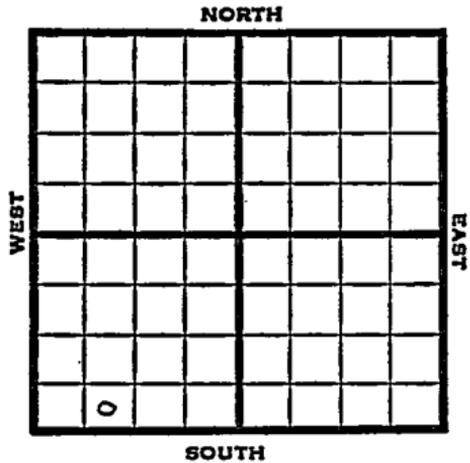

1951 Elev. 2196' REPORT

8/15 Spud 8-10-51
10" @ 361
Drlg. 2280'

9/5 Spud 8-10-51
Oil Well TD 3686
10" @ 361
Heeb. 3326 Lans. 3366
Arb. 3663-67
5" @ 3664 TD 3674
S/2½ boph 2 hr.
DD 3679 S/5 boph
10 hr. DD 3686
S/10 boph 4 hr 500 A
S/10 boph 18 hr
Comp. 391 bopd

COMPLETED

