

Graham

KANSAS

SECTION 10 TOWNSHIP 9 RANGE 21W

WELL NO. #3 Clack "A"

COMPANY Continental

NORTH

12

WEST

EAST

0

SOUTH

Graham

KANSAS

SEC. 10	TWP. 9	R. 21W
------------	-----------	-----------


WELL NO. #3 Clack "A" FARM

COMPANY Continental

CONTRACTOR L&J

Morel

_____ Ft. from N. Line
 _____ Ft. from S. Line
 _____ Ft. from E. Line
 _____ Ft. from W. Line

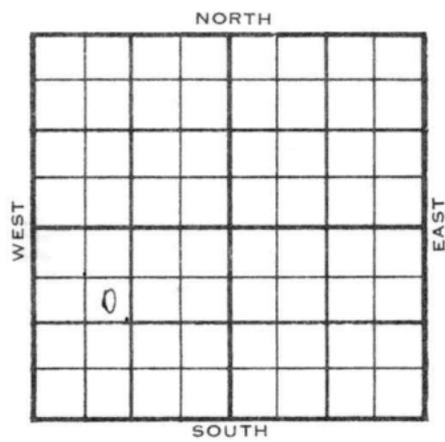

~~SE NW SW~~

1956	ELEVATION 2187'	REPORT
------	--------------------	--------

5-2
5-23

Location
 Comm. 5-4-56
 8 5/8" @ 262 w/150
 5 1/2" @ 3669 w/150
 CO 3672
 FU 200' oil in 30 min,
 S/ 42 BO, no/wtr., 4 hrs.
 DD 3674
 S/ 127 BO, no/wtr., 7 hrs.
 P/ 476 BO, no/wtr., 24 hrs.
 Grav. 28.
 Anh. 1660', H. 3325', L. 3365', A. 3667'
 TD 3672'

COMPLETED

County Graham Elev. 2187
 Sec. 10 Twp. 9 Rge. 21W
 Company Continental
 Farm Name Clack "A" No. 3

TOPS	DEPTH	LOG	DATUM	Loc. in Sec.
Anb.	1660			SE NW-SW
Tp.				
H.	39251			SW NW
Tr.				
Dg.				
Bl.				
L.	3365		1178	Geol.
K.C.				Contr.
B.K.C.				L & J
Ce.				Pool
C.				Morel
M.				
M.				
K.				
Mz.				
Mo.				
V.				
S.				
S.				
A.	3667		1480	COMPLETE
R.				
Pe.				
G.				
T.D.	3672			

Date Comm.

MAY 23 1956

Location MAY 9 '56 5-4-56

8 5/8 262/150 @ 2780 MAY 15 '56

5 1/2 3669/150 CO 3672 FU 200'

oil in 30" MAY 23 '56 \$ 42 Bo no/w

4 hrs DD 3674 \$ 127 Bo no/w

7 hrs Pop. Ph P 476 Bo no/w

24 hrs. gravit 28°