


Graham

KANSAS

SECTION 10 TOWNSHIP 9 RANGE 21W

WELL NO. #1 Desaire

COMPANY H.G. Kaiser & K & E Drlg.

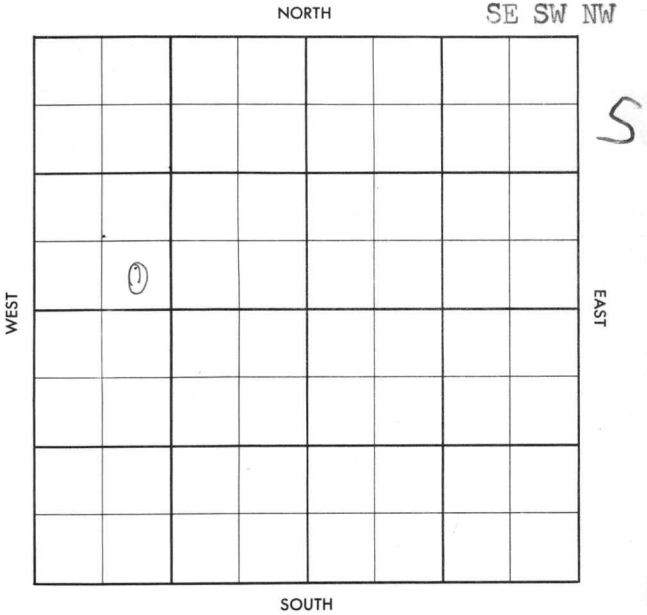

County Graham Elev. _____
Sec. 10 Twp. 9 Rge. 21W
Company H. G. Kaiser & K & E Drlg.
FarmName Desaire No. 1

TOPS	DEPTH	LOG	DATUM	Loc. in Sec.
Anh.				SE SW NW
Tp.				
H.				
Tr.				
Dg.				
BL.				
L.				Geol.
K.C.				Contr.
B.K.C.				K & E Drlg.
Ce.				
C.				
M.				Pool
M.				Morel
K.				
Mz.				
Mo.				
V.				
S.				
S.				
A.				
R.				
Pe.				
G.				
T.D.				

Date Comm. M I R

5

Co.
Lse.
No.
Sec.
T.
R.

FIRST REPORT
0
JAN 23 '57

County Graham Elev. 2162
 Sec. 10 Twp. 9 Rge. 21W
 Company H. G. Kaiser & K & E Drlg.
 Farm Name Desaire No. 1

TOPS	DEPTH	LOG	DATUM	Loc. in Sec.
Anh.				SE SW NW
Tr.				
H.				
Dg.				
BL.				
L.	3352			Geol.
K.C.				Contr.
B.K.C.	3574			K & E Drlg.
Ce.				Pool
C.	3574			Morel
M.				
M.				
K.				
Mz.				
Me.				
V.				
S.				
S.				
A	720 ATB			
R.				
Pe.				
G.				
T.D.	3705			ABANDONED

Date Comm.

M I R JAN 30 '57 1-22-57 85/8
 249/150 11 3660 FEB 9 '57
 DST 3572-3705 1hr run 70' MD
 BHP 160/30"

D & A