

KANSAS


FORM 51 5M PETROL

Graham

Section 10 Township 9 Range 21-W

Well No. #3 Loveridge

Company Continental & Cities Service

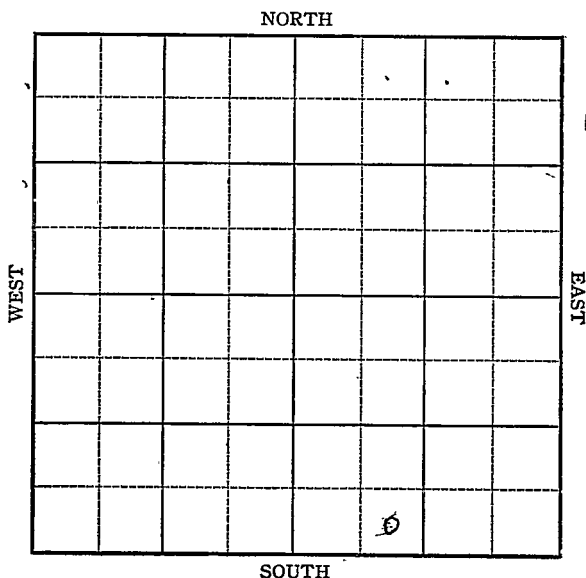

KANSAS

Graham

Sec. 10 Twp. 9 R. 21-W

Well No. #3 Loveridge Farm

Continental & Cities Service Company




Ft. from N. Line

330 Ft. from S. Line

Ft. from E. Line

990 Ft. from W. Line

Elev. 2210

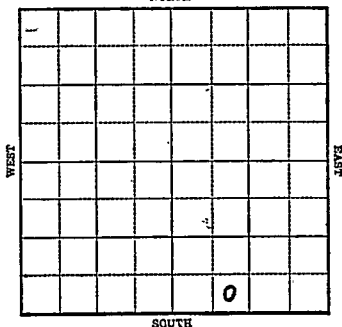

SOUTH

1943

REPORT

10/20 Derrick

10/27 Rotary

11/3 10th @ 242
Dr1g. 2210'

11/10	Simp 3694
	T.D. 3703
	6" @ 3702'
	Rust

11/17 | " "

11/24	TD 8711
	2000 acid
	bail 1 oil per hr. 4 hrs.

12/1 TD 3790
1 bailer oil + 5 balers water.
Pert. P.B.

12/83 PB 3730
WOC

12-15 PB 3728'
1 $\frac{1}{2}$ oil & 1 $\frac{1}{2}$ water per hr.

12/22	6" @ 3702
	Simpson 3694
	TD 3790
	PB 3728
	Acid 2500
	Pump 97 Pot
	Gravity 27

COMPLETED

KANSAS


Map No. 65 Sec. 10 Twp. 9 R. 21WWell No. 3 LoveridgeContinental & Cities Service
Company

FIRST REPORT

Contractor

SE SW SE

SECTION PLAT

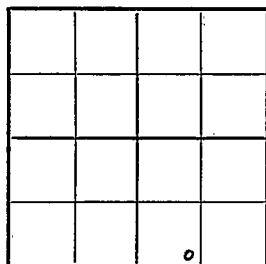 Ft. from N. Line330 Ft. from S. Line Ft. from E. Line990 Ft. from W. Line

Morel Pool

Location Rig up

Drilling and Remarks:

Derrick

RECORD

Cased in., ft.Sand Gas Oil Total Depth

PRODUCTION

1st 24 hrs. Nat. 1st 24 hrs. after shot Gas Cu. Ft.Dry Hole Abandoned

Date

OCT 20 1943 19 S. J. LEWIS Scout

Map No. KASAS Sec. 10 Twp. 9 R. 21WWell No. 3 LoveridgeContinental & Cities Service CompanyCOMPLETED

Contractor

SE SW SE

SECTION PLAT

Ft. from N. Line

330 Ft. from S. Line

Ft. from E. Line

990 Ft. from W. LineMorel Pool

Location _____

Rig up _____

Drilling and Remarks:

*Simpson 3694**6408702**PB 372.8 2500 and**Pump 97 P. 8**27° 32'*

RECORD

Cased _____ in., _____ ft.

Sand _____

Gas _____

Oil _____

Total Depth 3790

PRODUCTION

1st 24 hrs. Nat. _____

1st 24 hrs. after shot _____

Gas _____ Cu. Ft.

Dry Hole _____

Abandoned _____

Date

DEC 22 1943

19

S. J. LEWIS

Scout