


Section 10 Township 9 Range 22-W

Well No. #2 Swayze

Company Gulf Oil

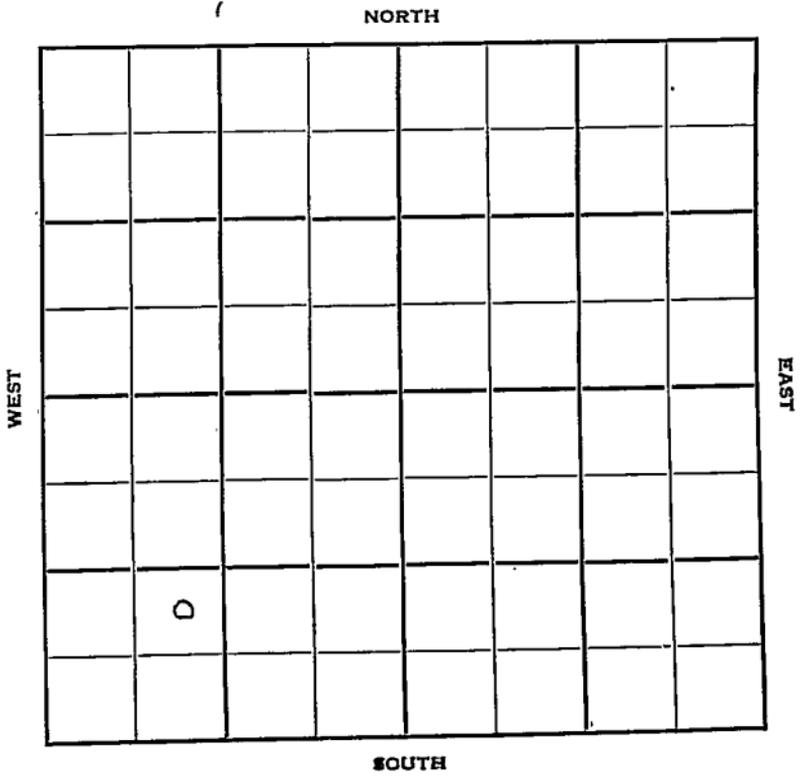

Sec. 10 Twp. 9 R. 22-W

Well No. #2 Swayze Farm

Gulf Oil Company

Herndon Drlg. Contractor

Wildhorse Creek


\_\_\_\_\_ Ft. from N. Line

990 Ft. from S. Line

\_\_\_\_\_ Ft. from E. Line

990 Ft. from W. Line

NE SW SW

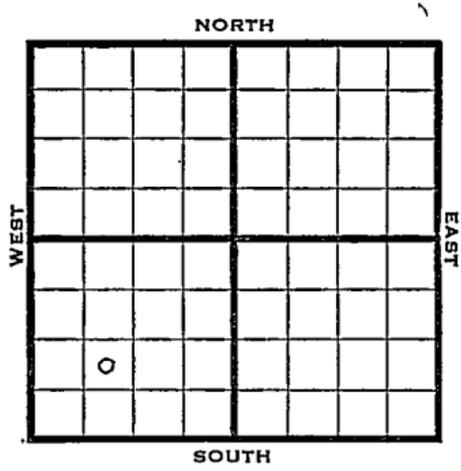

1950

Elev 2266

REPORT

7/19 Spud 7-17-50

8/30 Anhy 1809

8" @ 1826

Lans 3536

Arb 3885 $\frac{1}{2}$ -92

5" @ 3887

TD 3892

2000 A

S/35 bwph

D&A

**ABANDONED**

Map No. \_\_\_\_\_ Sec. 10 Twp. 9 R. 22WWell No. 2 SwayzeGulf Oil CompanyHerndon Drlg. Contractor

NE SW SW

\_\_\_\_\_ Ft. from N. Line

990 Ft. from S. Line

\_\_\_\_\_ Ft. from E. Line

990 Ft. from W. Line

## SECTION PLAT

0			

Graham County

Location \_\_\_\_\_

Rig up \_\_\_\_\_

Drilling and Remarks:

Spud 7-17-50

## RECORD

Cased \_\_\_\_\_ in., \_\_\_\_\_ ft.

Sand \_\_\_\_\_

Gas \_\_\_\_\_

Oil \_\_\_\_\_

Total Depth \_\_\_\_\_

## PRODUCTION

1st 24 hrs. Nat. \_\_\_\_\_

1st 24 hrs. after shot \_\_\_\_\_

Gas \_\_\_\_\_ Cu. Ft.

Dry Hole \_\_\_\_\_

Abandoned \_\_\_\_\_

Date

JUL 19 1950

19

J. E. TYRA

Scout

