DX 78-1


Graham

KANSAS

Section 10 Township 9 Range 24 W

Well No. #2 Clark

Company ~~Sunray Mid-Continent~~

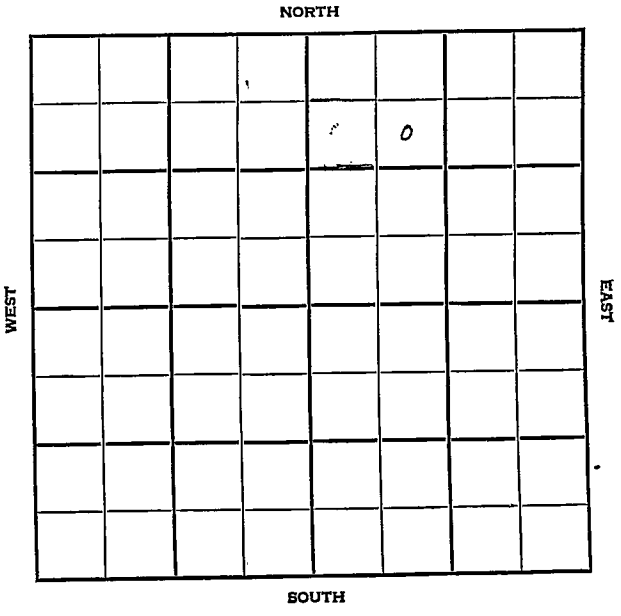

(DEVELOPMENT) Graham KANSAS

FILE

SEC.	TWP.	R.
10	9 S	24 W

WELL NO. # 2 M. Clark FARM

COMPANY Sunray Mid-Continent

CONTRACTOR Stickle Drlg.

Holly Pool

990 Ft. from N. Line

Ft. from S. Line


Ft. from E. Line

~~990~~ Ft. from W. Line

of ~~NW/4 NE/4~~ NE/4

~~SE NW NW~~

~~SE NW NE~~ SENWNE

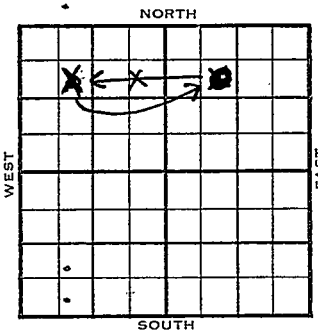

1955	ELEVATION REPORT
7/28	Location - WOC 8-5/8" @ 300' (Spud date to follow) (DR #147)
7/29	WOC 8-5/8" csg. Spud 7-27-55 (ERROR ON DR #148) ~~(Corrected location 990' FWL & 990' FNL of NW/4)~~ (DR #148)
8/1	Drlg. 3200'
8/2	Drlg. 3440' (F.R. Ticket)
8/3	~~TDXL4032XXXPxxxx~~ Drlg. 3690'
8/4	Drlg. 3690' Lansing (1' low to Clark #1)
8/5	Drlg. 3980'
8/8	TD 4042' WOC 5½" @ 4040'
8/9	TD 4042' Bailing
8/10	TD 4042' DOC to 4010'. Rng EL
8/11	TD 4042' Perf 3972-78' - Kansas City zone - Acidized & swabbed load oil & acid wtr. No show. Prep to set plug & treat zone 3954-60'
8/12	TD 4042'. Perf 3955-59. Acidized. Recovered load oil & acid water. Swabbed 8 hrs @ 66 BO & 60 BW/day rate. Prep to test 3937-43'

DX-78

OVER

1955

8/15 TD 4042'. Prep to install pumping equip. Perf 3937-41' DST - flowed 3 BO & 1½ BW/hr for 3 hrs. Acidized perfs 3937-41' & 3955-59'. Swabbed 96 BO & 36 BW/d rate.

8/16 TD 4042'. Prep to run tbg & rods.

8/17 TD 4042' Installing pumping equip.

8/18 TD 4042' " "

8/19 TD 4042' " "

8/22 TD 4042' Prep to test.

8/23 " "

8/24 " "

8/25 TD 4042'. Tested perfs 3937-41 & 3955-59'. Lansing & Kansas City Zones Pumped 148 BO & 14 BW/day -COMPLETE

8-25 Waiting on potential

8/31 Comm 7/28/55

H	3739	3744
Tr	3775	3769
L	3789	3785
BKC		4004
TD	4042	

8 5/8" @ 300 w/250 -

5 1/2" @ 4040 w/150 -

36/3972-78 1250 acid no show plg 3965

24/3955-59 test 9 goph plus 5 gwph for 4 hrs 1250 acid Swb 22 bo plus 20 bw in 8 hrs Plg 3949 24/3937-41 tst 3 bo plus 1½ bwph for 3 hrs 1250 acid tst 44 bf in 8 hrs t

tst 24 bo plus 20 20 bw nt.

Droge plg 2960

Re Acid PF 3937-41 & 3955-59, 3,000 acid

Swb 4 bo plus 1½ bw per hr for 3 hrs

T & R POP

St test pmp 160 bopd plus 9% [redacted] wtr

lst PF 3937-41

3955-59

COMPLETED

FORM 513 REV. SUNRAY

County Graham Elev.

Sec. 10 Twp. 9 Rge. 24W

Company Sunray Mid-Continent

Farm Name Clark No. 2

TOPS	DEPTH	LOG	DATUM
Anh.			
Tp.			
H.			
Tr.			
Dg.			
B.L.			
L.			
K.C.			
B.K.C.			
Ce.			
C.			
M.			
M.			
K.			
Mz.			
Mq.			
V.			
S.			
S.			
A			
R.			
P€.			
G.			
T.D.			

Loc. in Sec. SE NW NE

Geol.

Contr.

Pool Holly



Date Comm. 7-28-55

drlg. 3440 8 5/8 c. 300/250

Co. Lse. No. Sec. T. R.

FORM 513 REV. SUNRAY

County Graham Elev. 2461 KB

Sec. 10 Twp. 9S Rge. 24W

Company Sunray Mid-Continent

Farm Name Clark No. 2

TOPS	DEPTH	LOG	DATUM
Anh.			
Tp.			
H.	3739	3744	1283
Tr.	3775	3769	1308
Dg.			
Bl.			
L.	3789	3785	1324
K.C.			
B.K.C.		4004	1543
Ce.			
C.			
M.			
M.			
K.			
Mz.			
Mo.			
V.			
S.			
S.			
A			
R.			
P€.			
G.			
T.D.	4042		

Loc. in Sec. SE NW NE

Geol.

Contr.

Lse.

Pool Holly

COMPLETE

No.

Date Comm. 7/28/55 AUG 31 1955

Sec.

8 5/8" 300 w/250 5 1/2" 4040 w/150

36/3972-78 1250 acid no show plg 3965

T.

24/3955-59 test 9 goph plus 5 gwph for

4 hrs. 1250 acid Swb 22 bo plus 20 bw in

8 hrs. Plg 3949 24/3937-41 test 3 bo

plus 1 1/2 bwph for 3 hrs 1250 acid

tst 44 bf in 8 hrs. tst 24 bo plus 20

20 bw n.t. Drove plg 3960

R.

Re acid PF 3937-41 & 3955-59 3,000 acid

OVER

Swb 4 bo plus 1 1/2 bw per hr for 3 hrs.
T & R POP.

St test pmp 160 bopd plus 9% wtr.
lsg PF 3937-41
3955-59

