

Graham

KANSAS

Section 10 Township 9 Range 24W

Well No. #2 Ida Keith

Company N C R A

NORTH

WEST

EAST

SOUTH

0

1

2

Graham KANSAS

SEC. 10	TWP. 9	R. 24W
---------	--------	--------

WELL NO. 2 Ida Keith FARM

COMPANY N C R A


CONTRACTOR Braden D. lg.
Holly Pool

990 Ft. from N. Line

Ft. from S. Line

Ft. from E. Line

990 Ft. from W. Line

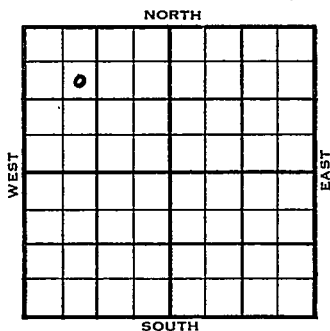


SE NW NW

1955	ELEVATION 2426'	REPORT
------	-----------------	--------

1/19
3/16

MIR
Spud 1-22-55 Oil Well TD 3990
10" @ 235, Heeb 3720, Lans 3759,
DST 3900-20, open 1 hr, Rec 60'
gassy oil, 120' SMO 1100#
DST 3930-42 open 1 hr. Rec 10'
mud 105# (TD 3985) 7" @ 3985
CO to 3953 24/3917-23
500A S/45 BO 11 hr 1000 A
S/70 BO 8 hr. Comp 126 BOPD

COMPLETED

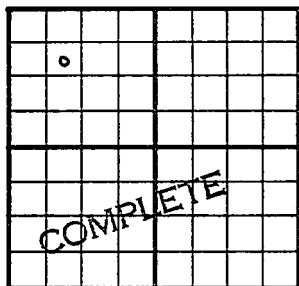County Graham State KansasSec. 10 (Blk. 9) (Sur. 24W) Map No. 24WOperator N C R AWell No. 2 Farm Ida KeithElev. 2426 Location SE NW NW990 Ft. From N Line NW990 Ft. From W Line Quarter

1st. Report

Completion MAR 1 6 1955Remarks Holly PoolBraden Drlg. - Contr.Spudding Date 1-22-55Drlg. Data Oil well TD 399010" @ 235 Heeb. 3720 Lans. 3759DST 3900-20 open 1 hr. Rec. 60' gassyoil 120' smo 1100# DST 3930-42open 1 hr. Rec. 10' mud 105# TD 39857" @ 3985 CO to 3955 24/ 3917-23500 A S/ 45 bo 11 hr. 1000 AS/ 70 bo 8 hr. Comp. 126 bopd

FABEN GILSTRAP