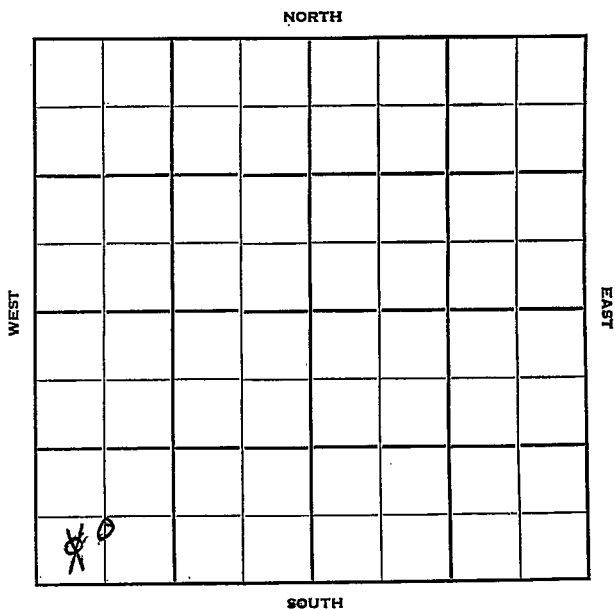


KANSAS

Osborne

Section 11 Township 9 Range 14-WWell No. #1 HeitachmidtCompany Markham

KANSAS Osborne

Sec. 11 Twp. 9 R. 11-W ✓

Well No. #1 Heitschmidt Farm

Markham Company

Allison Contractor


Wildcat

550' Ft. from N. Line

330' Ft. from S. Line

660' Ft. from E. Line

330' Ft. from W. Line

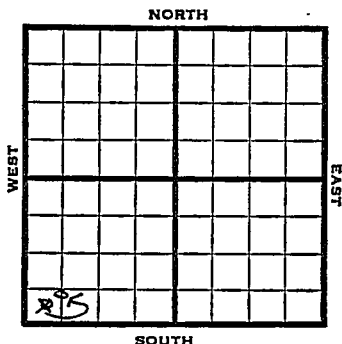

~~SW SW SW~~
CSL SW SW

1950

Elev. 1943' REPORT


11/8

Location

12/13

Spud 11-24-50
D&A TD 3922
8" @ 170' Anhy 1150-95
KC 3214' Heeb. 3156'
Br. Lime 3196' Lans. 3214
Cong. 3737' Miss 3770
Viola 3788' Simp 3892'
TD 3922' D&A

ABANDONED

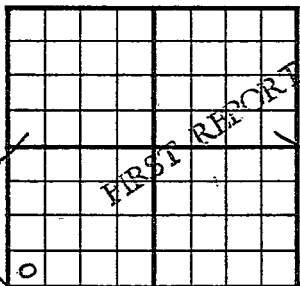County Osborne State KansasSec. 11 (Blk. Twp.) 9 (Sur. Rge.) 14W Map No.Operator MarkhamWell No. 1 Farm HeitschmidtElev. Location SW SW SW330 Ft. From S Line SW330 Ft. From W Line Quarter1st. Report NOV 8 1950

Completion

Remarks Eans. testAllison - Contr.

Spudding Date

Drlg. Data WildcatLocation

Map No. _____ Sec. 11 Twp. 9 R. 14WWell No. 1 Heitschmidt

_____ A. H. Markham _____ Company

_____ **CORRECTION** _____ Contractor

C S L SW SW

SECTION PLAT


_____ Ft. from N. Line

550 Ft. from S. Line

_____ Ft. from E. Line

660 Ft. from W. Line

Osborne County

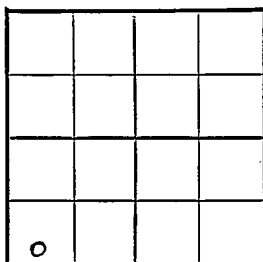

Location _____

Rig up _____

Drilling and Remarks:

Reported

SW SW SW

RECORD

Cased _____ in., _____ ft.

Sand _____

Gas _____

Oil _____

Total Depth _____

PRODUCTION

1st 24 hrs. Nat. _____

1st 24 hrs. after shot _____

Gas _____ Cu. Ft.

Dry Hole _____

Abandoned _____

Date


NOV 22 1950

19

J. E. TYRA

Scout

County Osborne State Kansas
 Sec. 11 (Blk.) 9 (Sur.) 14W Map No.
 Operator A. H. Markham
 Well No. 1 Farm Heitschmidt
 Elev. 1943 Location C S L SW SW

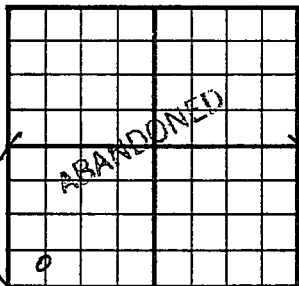

550 Ft. From S Line SW
660 Ft. From W Line Quarter
 Ist. Report
 Completion DEC 13 1950
 Remarks Wildcat
Allison - Contr.
 Spudding Date 11-24-50

Drlg. Data D & A TD 3922
8" @ 170 Anhy 1150-95 KC 3214
Heeb. 3156 Br. lime 3196 Lans. 3214
Cong. 3737 Miss. 3770 Viola 3788
Simp. 3892 TD 3922 D & A