




*Rooks*

Map No. KANSAS Sec. 11 Twp. 9 R. 16<sup>w</sup>

Well No. 1-Livingood Farm

Stearns & Strubbe Company

NORTH

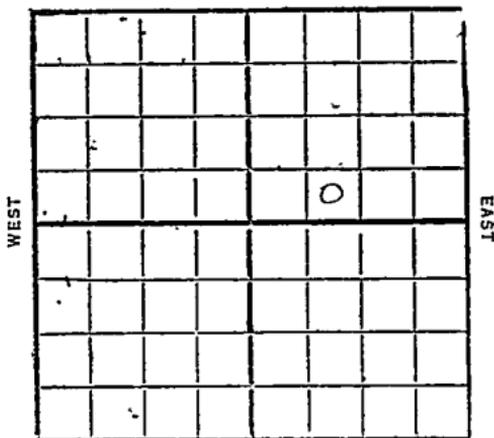

\_\_\_\_\_ Ft. from N. Line

330 Ft. from S. Line

\_\_\_\_\_ Ft. from E. Line

990 Ft. from W. Line

1931

SOUTH

Date

REPORT

Date	REPORT
2/4	Drilg rly
2/11	Drilg
2/18	Drilg
2/25	Drilg
3/4	Drilg
3/11	Drilg 625
3/18	" 8 950'
3/25	" 1070'
4/1	SD 1095'
4/8	Setg 12"-1313'
4/15	Drilg 1950'
4/22	" 8 2345'
4/29	10"-2380
	HFW 2435-2470
	UIR 10"
5/6	10"-2466
	Drilg 2695'
5/13	SD 2931'
5/20	Drilg 2957
5/27	Show oil 3015
	Drilg 3188'
	(over)

6/3- Top Oswald 3225  
25 bl sho 3300-07  
drlg 3325

6/10- 1/2 barrel water 3325-28  
5"-3451

drlg 3465'

6/17- HFW 3596-3600  
SID 3600' orders

6/24- Top Oswald 3225  
25 bl show 3300-07  
HFW 3596-3600  
T.D. 3600

Dry & abandon

*Roops*  
 Map No. **KANSAS** Sec. *11* Twp. *9* R. *16 W*  
 Well No. *Livingood*

*Stearns & Streeter* Company  
 Contractor

**SECTION PLAT**

..... Ft. from N. Line  
*330* Ft. from S. Line  
 ..... Ft. from E. Line  
*990* Ft. from W. Line


**FIRST REPORTS**

Location.....  
 Rig up.....  
 Drilling and Remarks:

*Building rig*

**RECORD**

Cased..... in., ..... ft.  
 Sand.....  
 Gas.....  
 Oil.....  
 Total Depth.....

**PRODUCTION**

1st 24 hrs. Nat.....  
 1st 24 hrs. after shot.....  
 Gas..... Cu. Ft.  
 Dry Hole.....  
 Abandoned.....

Date

**FEB 4 1931**

192.....

**S. J. LEWIS** Scout

*Brooks*

Map No. **KANSAS** Sec. *11* Twp. *9* R. *16*<sup>W</sup>

Well No. *1* *Livingood*

*Stearns & Streetes* Company

Contractor

**COMPLETE**

**SECTION PLAT**

.....Ft. from N. Line  
*330* Ft. from S. Line  
 .....Ft. from E. Line  
*990* Ft. from W. Line

		o	

**ABANDONED**

Location.....

Rig up.....

Drilling and Remarks:  
*1 Oswald 3775*  
*75 hl Ahew 3300-07*  
*HFW 3596-3600*

**RECORD**

Cased.....in., .....ft.  
 Sand.....  
 Gas.....  
 Oil.....  
 Total Depth.....*3600*

**PRODUCTION**

1st 24 hrs. Nat.....  
 1st 24 hrs. after shot.....  
 Gas.....Cu. Ft.  
 Dry Hole.....  
 Abandoned.....

Date

**JUN 24 1931**

**CHAS. L. SHERWOOD**  
 Scout