


Section 11 Township 9 Range 16-W

Well No. 1 Livengood

Company Broadview Oil

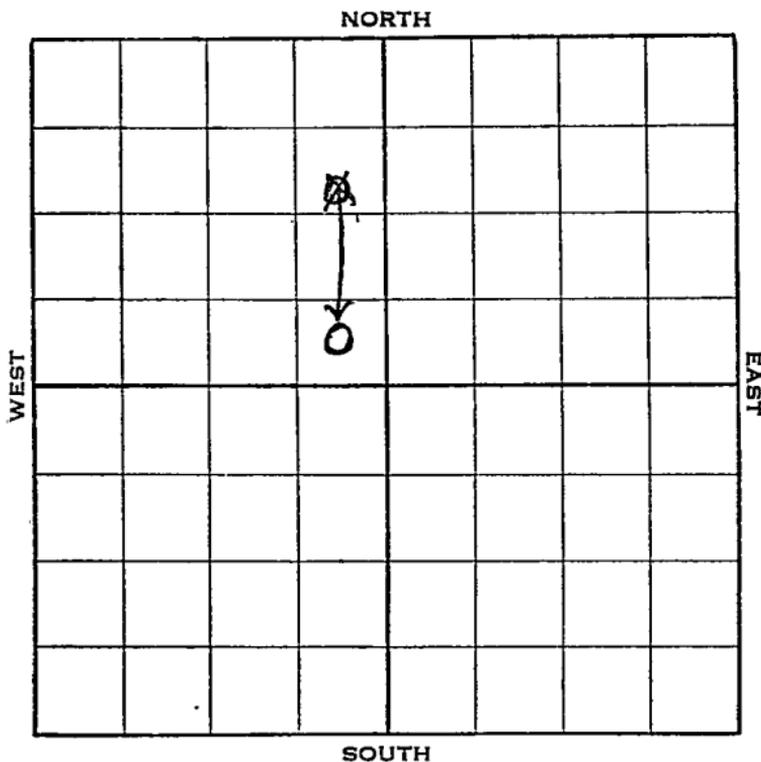

Sec. 11 Twp. 9 R. 16-W


Well No. #1 Livengood Farm
Broadview Oil Company

~~1015~~ Ft. from N. Line

330 Ft. from S. Line

330
~~309~~ Ft. from E. Line

_____ Ft. from W. Line

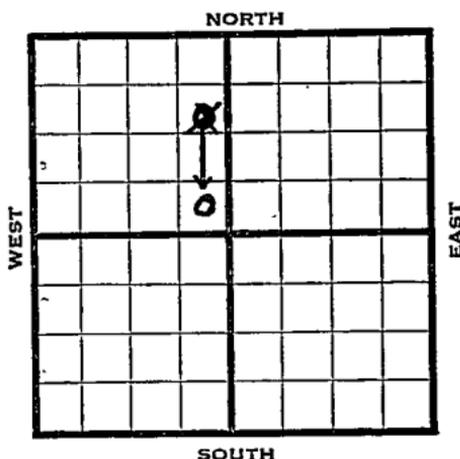

1938	REPORT
3/30	Location
4/8	"
4/15	"
4/22	"
4/29	"
5/6	"
5/12	"
5/20	"
5/27	"
6/3	"
6/10	C. R.
6/17	R.U.
6/24	SD.
7/1	"
7/8	"
7/15	"
7/22	"
7/29	13" - 755'. Dlg. 980'.
8/5	Anhy. 1298'. 10" - 1310'.
	U. R. 1315'.
8/12	Dlg. 1980'.

OVER

1938

8/19 8" - 2408'.
T. D. 2575'. U. R.

8/26 8" - 2630'. C.O. 2731'.

9/2 8" - 2790'. Dlg. 2950'.

9/9 " " " " "

9/16 8" - 2935'. S. O. - 2960-65'.
7" - 3203'. Top Lans. ?
T. D. 3250'. 1500' oil.

9/23 Lans. 3212'. 7" - 3240'.
Pay 3242-50' T. D.
Swab 7 oil per hour.

9/28 7" at 3240'.
Lans. 3212'.
T. D. 3250'.
15 bbls. oil.

COMPLETED

Map No. 64 Sec. 11 Twp. 9 R. 16W

Well No. 1 Livengood

Broadview Oil Company

Contractor

FIRST REPORT

SECTION PLAT

Approx.
SE NE NW
1015 Ft. from N. Line

	0		

_____ Ft. from S. Line

309 Ft. from E. Line

_____ Ft. from W. Line

Location X

Rig up _____

Drilling and Remarks:

RECORD

Cased _____ in., _____ ft.

Sand _____

Gas _____

Oil _____

Total Depth _____

PRODUCTION

1st 24 hrs. Nat. _____

1st 24 hrs. after shot _____

Gas _____ Cu. Ft.

Dry Hole _____

Abandoned _____

Date

MAR 30 1938 19

H. D. Hatfield Scout

Rooks KANSAS

Map No. 64 Sec. 11 Twp. 9 R. 16^w

Well No. 1-Livengood

Broadview Oil Company

1 Contractor

SE NW

CORRECTION

SECTION PLAT

		0	

_____ Ft. from N. Line

330 Ft. from S. Line

330 Ft. from E. Line

_____ Ft. from W. Line

CORRECTION

Location _____

Rig up _____

Drilling and Remarks:

*first reported
as SENE NW
corrected to
SE NW*

RECORD

Cased _____ in., _____ ft.

Sand _____

Gas _____

Oil _____

Total Depth _____

PRODUCTION

1st 24 hrs. Nat. _____

1st 24 hrs. after shot _____

Gas _____ Cu. Ft.

Dry Hole _____

Abandoned _____

Date

AUG 24 1938

19

H. D. Hatfield

Scout

Rooks KANSAS

Map No. 64 Sec. 11 Twp. 9 R. 16W

Well No. 1 Livengood

Broadview Oil

Company

Contractor

COMPLETED

SECTION PLAT

Approx. SE NW

_____ Ft. from N. Line

330 Ft. from S. Line

330 Ft. from E. Line

_____ Ft. from W. Line

	0		

Location _____

Rig up _____

Drilling and Remarks:

15 bbls

RECORD

Cased 7 in., 3240 ft.

Sand LENS 3212

Gas _____

Oil _____

Total Depth 3250

PRODUCTION

1st 24 hrs. Nat. _____

1st 24 hrs. after shot _____

Gas _____ Cu. Ft.

Dry Hole _____

Abandoned _____

Date

SEP 28 1938 19

H. D. Hatfield

Scout