

KANSAS

Form 51-5M-7-40-Palace


Rooks.

Section 11 Township 9 Range 16-W

Well No. #5 Livingood

Company Broadview Oil

Laton Pool

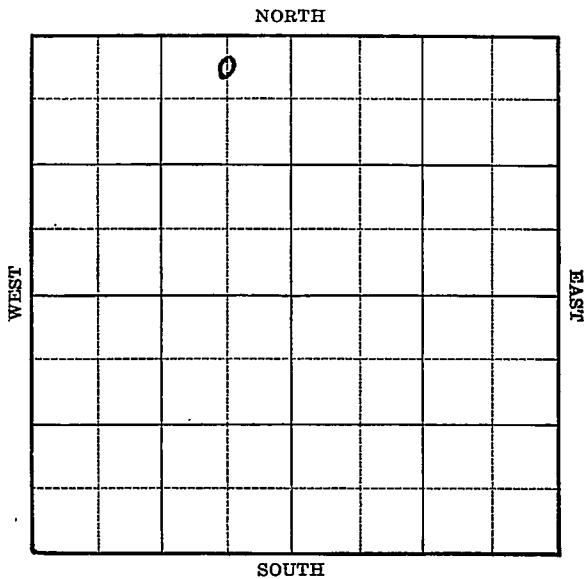

Map No. 64 Sec. 11 Twp. 9 R. 16WWell No. 5 LivingoodBroadview Oil Company

Contractor

FIRST REEL

C N L NE NW

330 Ft. from N. Line Ft. from S. Line660 Ft. from E. Line Ft. from W. Line

SECTION PLAT

	0		

LATON POOL

Location Rig up

Drilling and Remarks:

Bldg. Roty Rig

RECORD

Cased in., ft.Sand Gas Oil Total Depth

PRODUCTION

1st 24 hrs. Nat. 1st 24 hrs. after shot Gas Cu. Ft.Dry Hole Abandoned

Date

JUL 31 1940 19

S. J. LEWIS Scout

Map No. 64 Sec. 11 Twp. 9 R. 16WWell No. 5 Livingood

Broadview Oil

Company

Contractor

COMPLETED

C N L NE NW

330 Ft. from N. Line Ft. from S. Line660 Ft. from E. Line Ft. from W. Line

SECTION PLAT

LATON POOL

Location Rig up

Drilling and Remarks:

*Loss 3207**5" @ 3282.**4000 acid**Echometer P.D.**2356.*

RECORD

Cased in., ft.Sand Gas Oil Total Depth 3286

PRODUCTION

1st 24 hrs. Nat. 1st 24 hrs. after shot Gas Cu. Ft.Dry Hole Abandoned

Date

SEP 4 1940 19

S. J. LEWIS Scout