

Rooks Co

Ma ~~Kansas~~ Sec. 11 Twp. 9 R. 16 ^W

Well No. 1 Lushman Farm


~~O. W. Livingston~~ Company
Vickers Oil & Gas Co. NORTH

Ft. from N. Line

300 Ft. from S. Line

Ft. from E. Line

300 Ft. from W. Line

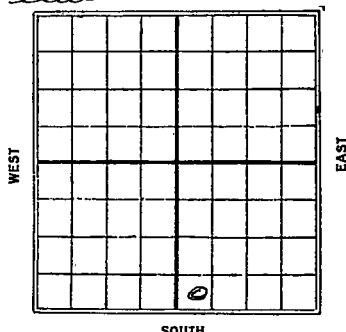

Date	REPORT
1926	
7/9	Spudding
8/30	Only 800
9/8	" 1030
9/15	—
9/22	Only 1115
9/29	No report
10/6	Only 1877
10/13	T.D. 1877 U.P.
10/20	No report
10/27	T.D. 1650-S.D.
11/3	No report
11/10	No report
11/17	T.D. 2070-U.P.
11/24	T.D. 2230 U.P. 8"
12/1	T.D. 2380' U.P. 8"
12/8	Same
12/15	T.D. 2490' Rig turned
12/21	moving in rig
12/29	Rig building
1927	
1/5	Rig bldg.
1/12	rigging up

1/19 — Rigging up
 1/26 — T.D. 2490 fishing back
 2/2 — Drlg 2490
 2/9 — T.D. 2450 — fishing pipe
 2/16 —
 2/23 — Cleaning out
 3/2 — T.D. 2450 — U.R.
 3/9 — Drlg 2160
 3/16 — Set 8" @ 2130 — Drlg 2160
 3/23 — Drlg 2265
 3/30 — T.D. 2380 — U.R. 8"
 4/6 — Drlg 2410
 4/13 — ~~T.D. 2200 fishing tools~~
 4/20 — T.D. 2475 — fishing bit
 4/27 — Drlg 2510
 5/4 — " 2580
 5/11 — " 2600
 5/18 — " 2750
 5/25 — " 2860
 6/1 — " 2910
 6/8 — " 2930
 6/15 — Show oil 3040 — Drlg 3045
 6/22 — 10 bbl. show 3140 — 45.
 Drlg 3202 —
 6/29 — T.D. 3206 — show oil — U.R. 6" —
 7/9 — Top oswald sandy lime 3228 —
 T.D. 3261 — swab 10 bbls. hr.
 Est @ 200 bbls. 31 gravity —
 7/13 — T.D. 3261 1/2 — pulled big pipe
 + bldg tanks swab 282 bbls.
 in 4 days.
 7/20 — Swabbing 17 bbls day —
 going on the pump
 7/27 — Rumping 62 bbls. per day —
 8/3 — " 55 " day light

Map No. KANS Sec. 11 Twp. 9 R. 16 W
 Well No. 1- Lushman Farm
Vickers Pet-et al Company

NORTH

Ft. from N. Line

300

Ft. from S. Line

Ft. from E. Line

300

Ft. from W. Line

WEST

EAST

SOUTH

REPORT

1927
 8/9 Pumping 50 bbls. per day.
 8/17 " 60 "
 8/23 " 60 "
 9/3 " 50 "
 9/7 Top. sdy line 3206
 T.D. 3261½'
 pumping 60 bbls
 1928 OWDD
 10/17 Drilled 3289'
 10/24 Drilled to 3319'
 P.B. to 3290'
 shot 10 gtr
 Pumping 40 bbls.
Comp.

KANSAS

Map No. _____ Sec. 11 Twp. 9 R. 16 W

Well No. 1 Lushman
O. V. Livingston Company

Contractor

FIRST REPORTS

SECTION PLAT

Ft. from N. Line

300 Ft. from S. Line

Ft. from E. Line

300 Ft. from W. Line

		0	

Location _____

Rig up _____

Drilling and Remarks:

Spudding

RECORD

Cased _____ in., _____ ft.

Sand _____

Gas _____

Oil _____

Total Depth _____

PRODUCTION

1st 24 hrs. Nat. _____

1st 24 hrs. after shot _____

Gas _____ Cu. Ft.

Dry Hole _____

Abandoned _____

Date

JUL 9 1926

CHAS. L. SHERWOOD

192

Scout

MAP No. _____ SEC. 11 TWP. 9S. R. 16WWELL No. 1 LubmanUnkens COMPANY_____
CONTRACTOR

SECTION PLAT

FT. FROM N. LINE_____
FT. FROM S. LINE_____
FT. FROM E. LINE_____
FT. FROM W. LINE

LOCATION _____

RIG UP _____

DRILLING AND REMARKS:

2. K. M.3228 T. Oswald3258 - 50 lbs
show.Best pay at T.D.200 lbsDATE 41.5/107/11 1927

RECORD

CASED _____ IN., _____ FT.

SAND _____

GAS _____

OIL _____

TOTAL DEPTH 326 1 1/2

PRODUCTION

1ST 24 HRS. NAT. _____

1ST 24 HRS. AFTER SHOT _____

GAS _____ CU. FT.

DRY HOLE _____

ABANDONED _____

SCOUT

Map No. **KANSAS** Sec. 11 Twp. 9 R. 16WWell No. 1 LaskmanO. V. Livingston Company

Contractor

SECTION PLAT

Ft. from N. Line

300 Ft. from S. Line300 Ft. from E. Line

Ft. from W. Line

		0	

FIRST REPORTS

Location -----

Rig up -----

Drilling and Remarks:

Spud

RECORD

Cased ----- in., ----- ft.

Sand -----

Gas -----

Oil -----

Total Depth -----

PRODUCTION

1st 24 hrs. Nat. -----

1st 24 hrs. after shot -----

Gas ----- Cu. Ft.

Dry Hole -----

Abandoned -----

Date

JUL 1 1926

S. J. LEWIS

Scout

Map No. _____ Sec. 11 Twp. 9 R. 16 WWell No. 1 LushmanVickers P & S. Co. Company_____
Contractor

SECTION PLAT

_____ Ft. from N. Line

200 Ft. from S. Line300 Ft. from E. Line

_____ Ft. from W. Line

		0	

Correction

Location _____

Rig up _____

Drilling and Remarks:

Vickers P & S.
has taken this
over from
O. V. Livingston

RECORD

Cased _____ in., _____ ft.

Sand _____

Gas _____

Oil _____

Total Depth _____

PRODUCTION

1st 24 hrs. Nat. _____

1st 24 hrs. after shot _____

Gas _____ Cu. Ft.

Dry Hole _____

Abandoned _____

Date

NOV 17 1920

S. J. LEWIS

Scout

KANSAS

Map No. _____ Sec. 11 Twp. 9 R. 16 WWell No. 1 LuskmanVickers & P. & S. Company_____
Contractor

SECTION PLAT

Ft. from N. Line300 Ft. from S. Line300 Ft. from E. Line_____
Ft. from W. Line

	1		
		0	

COMPLETED

Location _____

Rig up _____

Drilling and Remarks:

Th. & L. 3206TD 3261 1/2.Pumping 608 ft.

RECORD

Cased _____ in., _____ ft.

Sand _____

Gas _____

Oil _____

Total Depth _____

PRODUCTION

1st 24 hrs. Nat. _____

1st 24 hrs. after shot _____

Gas _____ Cu. Ft.

Dry Hole _____

Abandoned _____

Date

SEP 7 1927

192

S. J. LEWIS

Scout

Red for No tracing
 MAP NO. KAN 940 SEC. 11 TWP. 9 R. 16 W

WELL NO. 1 Luskman

Vickers P. D. COMPANY

CONTRACTOR

SECTION PLAT

_____ FT. FROM N. LINE

300 FT. FROM S. LINE

_____ FT. FROM E. LINE

300 FT. FROM W. LINE

OW II II

LOCATION _____

RIG UP _____

DRILLING AND REMARKS:

Aug. 3289

RECORD

CASED _____ IN. _____ FT.

SAND _____

GAS _____

OIL _____

TOTAL DEPTH _____

PRODUCTION

1ST 24 HRS. NAT. _____

1ST 24 HRS. AFTER SHOT _____

GAS _____ CU. FT.

DRY HOLE _____

ABANDONED _____

DATE

OCT 17 1928

192

S. J. LEWIS

SCOUT

Booth
no tracing
 MAP NO. KANSAS SEC. 11 TWP. 9 R. 16 W

WELL NO. 1 Lushman

Vickers P. & S. COMPANY

CONTRACTOR

SECTION PLAT

		0	

Ft. FROM N. LINE

300 Ft. FROM S. LINE

Ft. FROM E. LINE

300 Ft. FROM W. LINE

COMPLETED

LOCATION _____

RIG UP _____

DRILLING AND REMARKS:

Drilled to 3319
Plugged back to
3290
shot 109 to
Pumping 40 ft

RECORD

CASED: _____ IN. _____ FT.

SAND _____

GAS _____

OIL _____

TOTAL DEPTH _____

PRODUCTION

1ST 24 HRS. NAT. _____

1ST 24 HRS. AFTER SHOT _____

GAS _____ CU. FT.

DRY HOLE _____

ABANDONED _____

DATE

OCT 24 1928

S. J. LEWIS

SCOUT