


Rook

Form 51-5M-4-27-27423

Map No. KANSAS Sec. 11 Twp. 9 R. 16 ^W
Well No. 2 - Father Hurst Farm
Kruger et al Company

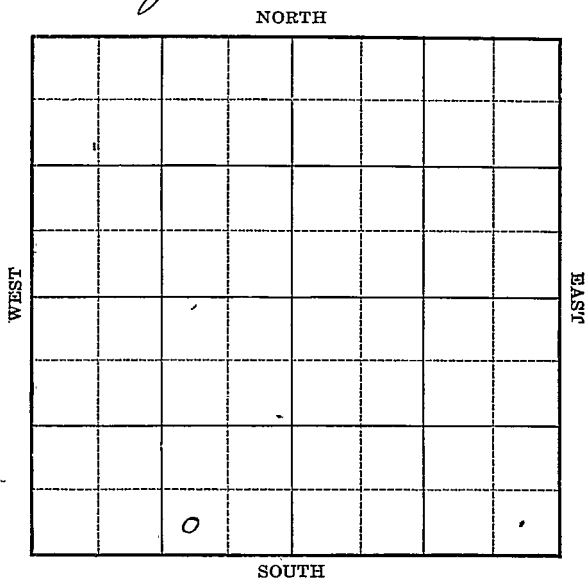

Location _____

Drilling Remarks _____

RECORD

Cased _____ in. _____ ft.

Sand _____

Gas _____

Oil _____

Total Depth _____

Rig Up _____

Drilling Remarks _____

PRODUCTION

1st 24 hrs. Nat. _____

1st 24 hrs. after shot _____

Gas _____ cu. ft.

Dry Hole _____

Abandoned _____


Map No. KANSAS Sec. 11 Twp. 9 R. 16 W
 Well No. 2- Jatenhurst Farm
Krueger et al Company

_____ Ft. from N. Line

330 Ft. from S. Line

990 Ft. from E. Line

_____ Ft. from W. Line

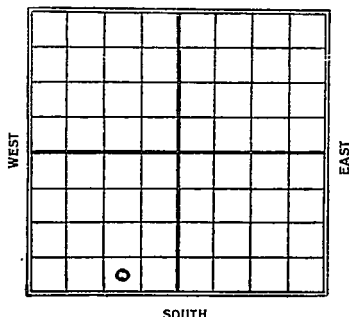

1928

Date

REPORT

9/26 Cellar

10/3 _____

10/10 Spud

10/17 _____

10/24 drilg 930'

10/31 " 1160'

11/7 " 1375'

11/14 " 2100'

11/21 " 2630'

11/28 " 2750'

12/5 " 3030'

12/12 show of oil 3250'

12/19 log bailer 3319 T.D.

12/26 drilg 3403'

1929

1/2 SD 3430-T.D.

1/9 swab 35 bbls 24 hrs.

1/16 SD. 3430-T.D.

1/23 2/20

1/30 2/27

2/6 (over)

2/13 _____

3/6- UIR 5"-3450'-T.D.

3/13 —

3/20- P.B. to 3270'

3/27 —

4/3- shot 20 gts 3240-45'

" 20 " 3270-75'

4/10 — Pkg out

4/17- T.D. 3584- HFW

dry & abandoned

MAP NO. KANSAS SEC. 11 TWP. 9 R. 16W
 WELL NO. 2 Ta therahurst

Krueger & Co COMPANY
 _____ CONTRACTOR

SECTION PLAT

_____ FT. FROM N. LINE
330 FT. FROM S. LINE
990 FT. FROM E. LINE
 _____ FT. FROM W. LINE

FIRST REPORTS

LOCATION _____

RIG- UP _____

DRILLING AND REMARKS:

O & H

RECORD

CASED _____ IN. _____ FT.
 SAND _____
 GAS _____
 OIL _____
 TOTAL DEPTH _____

PRODUCTION

1ST 24 HRS. NAT. _____
 1ST 24 HRS. AFTER SHOT _____
 GAS _____ Cu. Ft.
 DRY HOLE _____
 ABANDONED _____

DATE

SEP 26 1928

S. J. LEWIS

SCOUT

Map No. **KANSAS** Sec. 11 Twp. 9 R. 16W

Well No. 2. Hattenhurst

Krueger & Co. Company

Contractor

SECTION PLAT

_____ Ft. from N. Line

330 Ft. from S. Line

990 Ft. from E. Line

_____ Ft. from W. Line

ABANDONED

Location _____

Rig up _____

Drilling and Remarks: _____

NFW 3584

IIA

RECORD

Cased _____ in., _____ ft.

Sand _____

Gas _____

Oil _____

Total Depth 3584

PRODUCTION

1st 24 hrs. Nat. _____

1st 24 hrs. after shot _____

Gas _____ Cu. Ft.

Dry Hole _____

Abandoned _____

Date

APR 17 1929

S. J. LEWIS Scout