

# KANSAS

Form 51-5M-7-40-Palace


Rooks

Section 11 Township 9 Range 16-W

Well No. #6 Livingood

Company Broadview Oil

NORTH Laton Pool

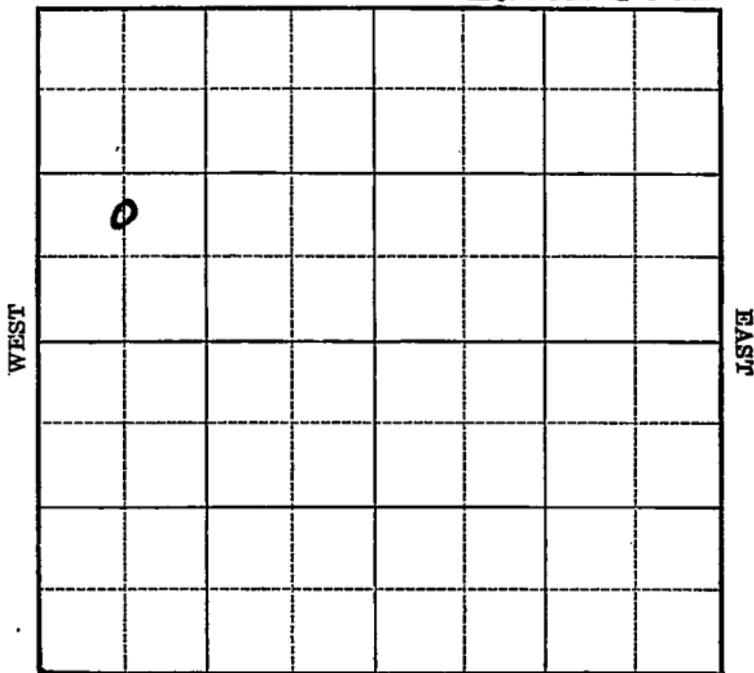

SOUTH



Map No. 64 Sec. 11 Twp. 9 R. 16W

Well No. 6 Livingood

Broadview Oil

Company

Contractor

FIRST REPORT

C N L SW NW

           Ft. from N. Line

990 Ft. from S. Line

           Ft. from E. Line

660 Ft. from W. Line

SECTION PLAT

o			

LATON POOL

Location X

Rig up           

Drilling and Remarks:

RECORD

Cased            in.,            ft.

Sand           

Gas           

Oil           

Total Depth           

PRODUCTION

1st 24 hrs. Nat.           

1st 24 hrs. after shot           

Gas            Cu. Ft.

Dry Hole           

Abandoned           

Date

AUG 7 1940 19

S. J. LEWIS Scout

Map No. 64 Sec. 11 Twp. 9 R. 16W

Well No. 6 Livingood

Broadview Oil Company

Contractor

**COMPLETED**

**SECTION PLAT**

C N L SW NW

o			

\_\_\_\_\_ Ft. from N. Line

990 Ft. from S. Line

\_\_\_\_\_ Ft. from E. Line

660 Ft. from W. Line

LAT ON POOL

Location \_\_\_\_\_

Rig up \_\_\_\_\_

Drilling and Remarks:

*Lans 3142*

*5" @ 3162*

*4000 acid*

*Dept. P. O. 2785*

**RECORD**

Cased \_\_\_\_\_ in., \_\_\_\_\_ ft.

Sand \_\_\_\_\_

Gas \_\_\_\_\_

Oil \_\_\_\_\_

Total Depth 3206

**PRODUCTION**

1st 24 hrs. Nat. \_\_\_\_\_

1st 24 hrs. after shot \_\_\_\_\_

Gas \_\_\_\_\_ Cu. Ft.

Dry Hole \_\_\_\_\_

Abandoned \_\_\_\_\_

Date

SEP 18 1940 19

S I LEWIS Scout