
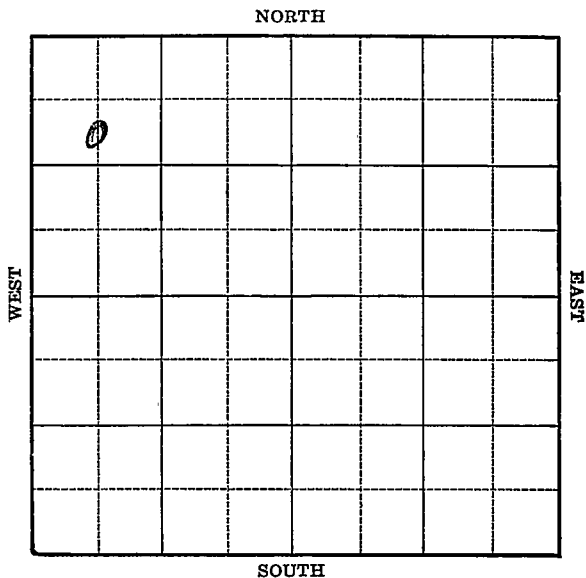


Section 11 Township 9 Range 16-WWell No. #7 LivingoodCompany Broadview Oil

(Laton)

660 Ft. from W. Line

Elev. 2015

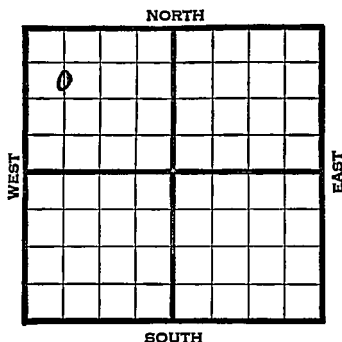

1940	REPORT
9/11	Rotary.
9/19	Anhy 1243' Drlg. 1244'
9/26	Drlg. 2754'
10/3	Lans. 3146' 5" - 3165' T.D.
	RUST.
10/10	Pay 3165-73' 900' oil 11 hrs.
	Pay 3199-3206' 1300' oil 15 hrs
	T.D. 3219' 8000 acid.
	2500' oil.
10/16	Lans. 3146'
	5" - 3165'
	T.D. 3219'
	8000 acid.
	Depthograph potential 2810 bbls.
	COMPLETED

Map No. 64 Sec. 11 Twp. 9 R. 16WWell No. 7 LivingoodBroadview Oil

Company

FIRST REPORT

Contractor

C S L NW NW

990 Ft. from N. Line Ft. from S. Line Ft. from E. Line660 Ft. from W. Line**SECTION PLAT**

o			

LATON POOL

Location Rig up

Drilling and Remarks:

Rotary

RECORDCased in., ft.Sand Gas Oil Total Depth **PRODUCTION**1st 24 hrs. Nat. 1st 24 hrs. after shot Gas Cu. Ft.Dry Hole Abandoned

Date

SEP 11 1940 19S. J. LEWIS Scout

Map No. 64 Sec. 11 Twp. 9 R. 16WWell No. 7 LivingoodBroadview Oil Company

Contractor

COMPLETED

C S L NW NW

990 Ft. from N. Line Ft. from S. Line Ft. from E. Line660 Ft. from W. Line

LATON POOL

SECTION PLAT

o			

Location Rig up

Drilling and Remarks:

*Lease 3146.**5 "C 8165**5000 acid**Depth. PT 2810***RECORD**Cased in., ft.Sand Gas Oil Total Depth 3219**PRODUCTION**1st 24 hrs. Nat. 1st 24 hrs. after shot Gas Cu. Ft.Dry Hole Abandoned

Date

OCT 16 1940 19S. J. LEWIS Scout