


Map No. KANSAS Sec. 11 Twp. 9 R. 16 W.
Well No. 1-Tatkenhurst Farm
Bruger et al Company

Well No. 1-Tatkenhurst Farm
Kruger et al Company
NORTH

Company

NORTH

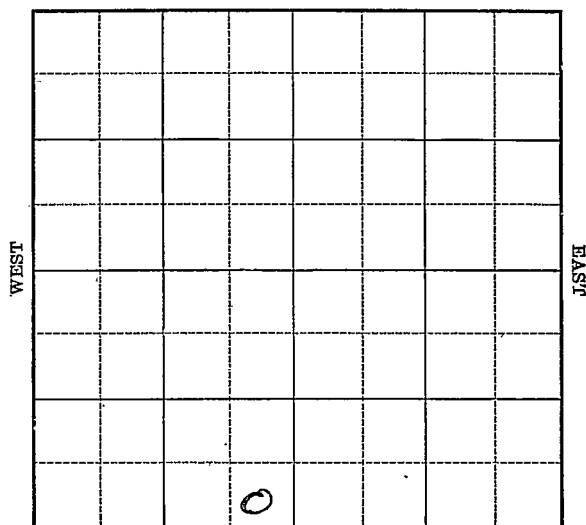

EAST

SOUTH

Location

Drilling Remarks

Rig Up

Drilling Remarks

RECORD

Cased_____in. _____ft.

Sand

Gas

Oil

Total Depth_____

PRODUCTION

1st 24 hrs. Nat. _____

1st 24 hrs. after shot-----

Gas _____ cu. ft.

Dry Hole_____

Abandoned


KANSAS

Map No. _____ Sec. 11 Twp. 9 R. 16W

Well No. 1-Tathenhurst Farm

Krueger et al Company

NORTH

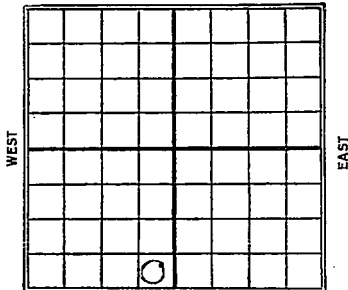

SOUTH

_____ Ft. from N. Line

330 Ft. from S. Line

330 Ft. from E. Line

_____ Ft. from W. Line

1927

Date REPORT

<u>11/9</u>	<u>R.O.G.</u>
<u>11/16</u>	<u>Bldg rig</u>
<u>11/22</u>	<u>Rig</u>
<u>11/29</u>	<u>Rigging up</u>
<u>12/7</u>	
<u>12/14</u>	<u>T.D. 165 - S.D.</u>
<u>12/21</u>	<u>Drly 300</u>
<u>12/28</u>	<u>" 425</u>
<u>1928</u>	
<u>1/4</u>	<u>" 600</u>
<u>1/11</u>	<u>T.D. 635 - S.D.</u>
<u>1/18</u>	<u>---</u>
<u>1/25</u>	<u>---</u>
<u>1/31</u>	<u>---</u>
<u>2/5</u>	<u>---</u>
<u>2/22</u>	<u>---</u>
<u>2/29</u>	<u>---</u>
<u>3/7</u>	<u>---</u>
<u>3/14</u>	<u>Drly 730</u>
<u>3/21</u>	<u>" 1000</u>
<u>3/28</u>	<u>no report</u>
<u>4/4</u>	<u>---</u>
<u>4/11</u>	<u>---</u>

4/18 - T.D. 1000 - S.D.
4/15 - Drlg 1305 -
5/2 - T.D. 1505 - u.R. 10" -
5/9 - Drlg 1540 -
5/16 - " 1560
5/23 - " 2245
5/31 - " 2400
6/6 - " 2500
6/13 - T.D. 2500 - fishing tools -
6/20 -
6/27 - T.D. 2500 - S.D.
7/3 -
7/11 - S.D. 2500
7/18 - Drlg 2635
7/25 - T.D. 2650 - u.R. 8" -
8/1 - Drlg 2835
8/7 - Drlg 2925
8/15 - " 2985
8/22 Top Oswald 3230
Drlg 3240 show oil
9/5 Top sand 3230
T.D. 3322
swabbed 175 bbls.
Comp.

Map No. **KANSAS** Sec. 11 Twp. 9 R. 16W

Well No. 1 Tathenhurst

Krueger & Co. Company

Contractor

SECTION PLAT

_____ Ft. from N. Line

330 Ft. from S. Line

330 Ft. from E. Line

_____ Ft. from W. Line

FIRST REPORTS

Location _____

Rig up _____

Drilling and Remarks:

ROY

RECORD

Cased _____ in., _____ ft.

Sand _____

Gas _____

Oil _____

Total Depth _____

PRODUCTION

1st 24 hrs. Nat. _____

1st 24 hrs. after shot _____

Gas _____ Cu. Ft.

Dry Hole _____

Abandoned _____

Date

NOV 9 1927

S. J. LEWIS

Scout

MAP No. KANSAS SEC. 11 TWP. 9 R. 16 W

WELL No. 1 Tatumhurst

Kriegel & Co COMPANY

CONTRACTOR

SECTION PLAT

FT. FROM N. LINE

330 FT. FROM S. LINE

330 FT. FROM E. LINE

FT. FROM W. LINE

COMPLETED

LOCATION

RIG UP

DRILLING AND REMARKS:

Top Sand 3230
Total Depth 3322

Drill 1750 ft

RECORD

CASED IN. FT.

SAND

GAS

OIL

TOTAL DEPTH

PRODUCTION

1ST 24 HRS. NAT.

1ST 24 HRS. AFTER SHOT

GAS CU. FT.

DRY HOLE

ABANDONED

DATE

SEP 5 1928

192

S. J. LEWIS

SCOUT