


Section 11 Township 9 Range 17-W

Well Number 1 Westhusin

Company L.C.D. Dlg. Co.

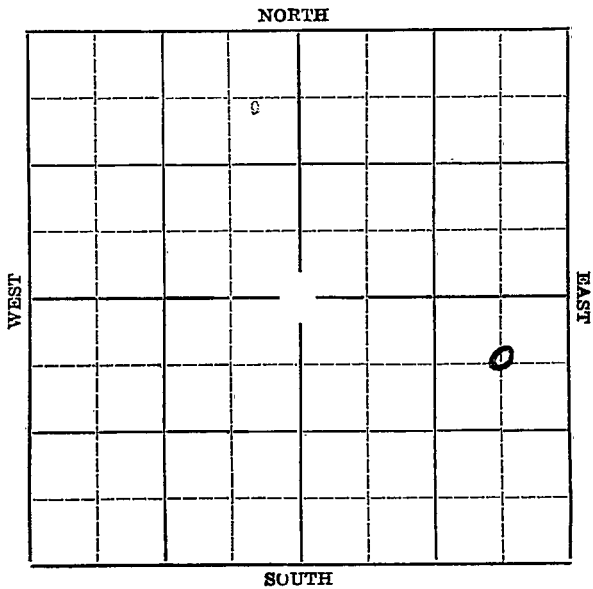

KANSAS

Map No. _____ Sec. 11 Twp. 9 R. 17WWell No. #1 Westhusin Farm _____

L.C.D. Drlg. _____ Company _____


660' Ft. from N. Line

_____ Ft. from S. Line

660' Ft. from E. Line

_____ Ft. from W. Line

Elev. 2024

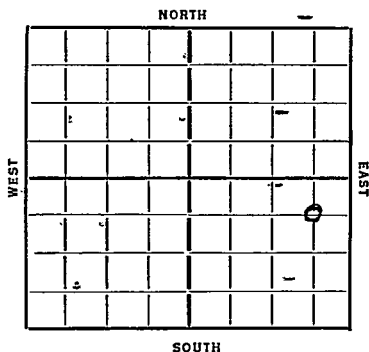

Date	REPORT
1936	
4/29	Cellar.
5/7	Material.
5/14	Building rig.
5/21	--
5/28	Rig and tools.
6/4	Rigging up.
6/11	Spud 60'.
6/18	Drlg. 520'.
6/25	550' Shut down.
7/2	--
7/9	10" @ 799'. 850' drlg.
7/16	Drlg. 1052'.
7/23	Drlg. 1296'.
7/30	Drlg. 2032'.
8/6	Drlg. 2375'.
8/13	Shut down.
8/20	2420' shut down.
8/27	--9/3--
9/10	2386' set 8". Clean out.
9/18	8" @ 2416'. Drlg. 2472'.
9/24	Fort Riley 1985'. Drlg. 2685'.

OVER

10/1-8" @ 2685'. TD 2690'. Clean out.
10/8-~~2200' X 3000' X 2000'~~. 8" @ 2691'. Dlg.
2910'.
10/15-Drlg. 695'.
10/22-Topeka 2885'. CORRECTED. Oswald
3141'. T.D. 3189'-200' of oil.
10/29-6" @ 3146'. TD 3192'-1800' of oil.
11/6-Swabbed 25 bbls. in 48 hrs.
Will drill deeper
11/12--Pay 3231-41 T. D.
Swabbed 36 bbls. 8 hrs. 1000'
off bottom. 37.5 gravity
at 72° Temp.
11/19--T. D. 3243 Swabbed 162 bbls.
24 hrs. 5000 acid. No test.
11/25 Lansing 3141'. T. D. 3243'.
5000 acid. Pot. 504 oil.
268 Water.

COMPLETED

KANSAS

Map No. 64 Sec. 11 Twp. 9 R. 17 NWell No. 1 MethuenL. C. H. H. 19 L.C.D. DLG Co. Company

Contractor

SECTION PLAT

660 Ft. from N. Line

Ft. from S. Line

660 Ft. from E. Line

Ft. from W. Line

FIRST REPORT

Location.....

Rig up.....

Drilling and Remarks:

Cellar

RECORD

Cased.....in.,ft.

Sand.....

Gas.....

Oil.....

Total Depth.....

PRODUCTION

1st 24 hrs. Nat.....

1st 24 hrs. after shot.....

Gas.....Cu. Ft.

Dry Hole.....

Abandoned.....

Date

APR 29 1936 192.....Scout

JIS

Map No. 64 Sec. 11 Twp. 9 R. 12WWell No. 1 WesthimerL C & D Mfg. Company

Contractor

SECTION PLAT

			0

660 Ft. from N. Line Ft. from S. Line660 Ft. from E. Line Ft. from W. Line

COMPLETED

Location Rig up

Drilling and Remarks:

Leasing 3141
5006 acil
108504 acil
268 Water

RECORD

Cased in., ft.Sand Gas Oil Total Depth 3243

PRODUCTION

1st 24 hrs. Nat. 1st 24 hrs. after shot Gas Cu. Ft.Dry Hole Abandoned

Date

NOV 25 1936 19 S. J. LEWIS Scout