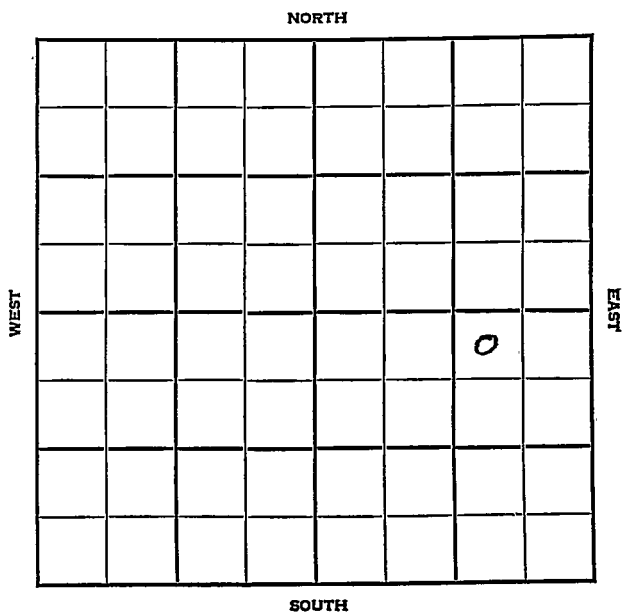


Section 11 Township 9N Range 17WWell No. #1 WesthusinCompany Delta Prod. et al

KANSAS


Rooks

Sec. 11 Twp. 9 R. 17WWell No. #1 Westhusin FarmDelta Prod. et al Company

Westhusin Pool

330' Ft. from N. Line Ft. from S. Line990' Ft. from E. Line Ft. from W. Line

NW NE SE

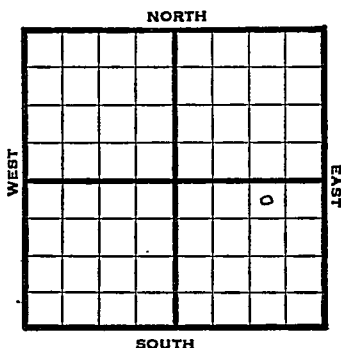

1948

Elev. 2004' REPORT

6/9

10" @ 102'
Anhy 1255'
Drlg. 1750'6/16
6/233293 fsg.
"

6/29

Whipstock 2780'

7/8

Drlg 3070'

7;14

5" @ 3408'

TD 3414'

7/21

Arbuckle 3404'?

7/28

"

8/4

"

8/11

"

8/18

"

8/25

"

9/1

Arbuckle 3408' corrected
TD 3414
Swb 8 bbls oil PH - 5 hrs.

9/8

Lans. 3130'
Arb 3408'
5" @ 3408'
TD 3414'
Depth Pot. 954 oil
Gr. 270

COMPLETED

Map No. _____ Sec. 11 Twp. 9 R. 17W

Well No. 1 Westhusin

Delta Prod. etal. Company

FIRST REPORT Contractor

NW NE SE

SECTION PLAT

330 Ft. from N. Line

_____ Ft. from S. Line

990 Ft. from E. Line

_____ Ft. from W. Line

			o

Rooks County

Location _____

Rig up _____

Drilling and Remarks:

10" @ 102

Anhy 1255

drlg. 1750

RECORD

Cased _____ in., _____ ft.

Sand _____

Gas _____

Oil _____

Total Depth _____

PRODUCTION

1st 24 hrs. Nat. _____

1st 24 hrs. after shot _____

Gas _____ Cu. Ft.

Dry Hole _____

Abandoned _____

Date

JUN 9 1948

19

S. J. LEWIS

Scout

Rooks County Kansas State
 Map No. 64 Sec. 11 Twp. 9 R. 17W

Well No. 1 Westhusin

Delta Prod. etal. Company

COMPLETE Contractor

NW NE SE

El. 2004
 SECTION PLAT

330 Ft. from N. Line

 Ft. from S. Line

990 Ft. from E. Line

 Ft. from W. Line

Westhusin Pool

Remarks:






27° 30'

Date
 SEP 8 1948

Scout
 S. J. LEWIS