

KANSAS

Rooks

Section 11 Township 9 Range 17WWell No. 1 Westhusin "C"Company Harbar**Westhusin**

NORTH

					0		

WEST

EAST

SOUTH

KANSAS

Rooks

Sec. 11 Twp. 9 R. 17W

Well No. #1 Westhusin "C" Farm

Harbar

Company

Westhusin Pool

 Ft. from N. Line

330'


 Ft. from S. Line

7

 Ft. from E. Line

990'

 Ft. from W. Line

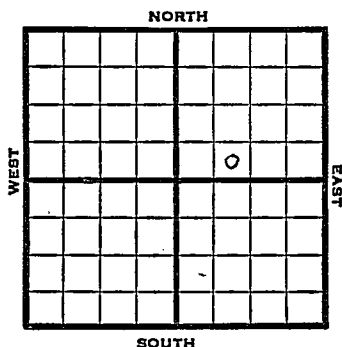

SE SW NE

1949	Elev 1995'	REPORT
3/23	Location	
3/30	"	
4/6	8"@ 90	
	Drlg 2905'	
4/12	Lansing 3225'	
	Arb. 3410'	
	TD 3414	
	5"@ 3410'	
4/20	250 acid	
	Swb 2 bbls oil PH	
4/27	"	
5/4	"	
5/11	TD 3414'	
	Arb 3410'	
	5"@ 3410'	
	Pump 50 Oil Pot	
	27° Gr.	
	Comp	
	COMPLETED	

Map No. _____ Sec. 11 Twp. 9 R. 17W

Well No. 1 Westhusin "C"

Harbar

Company

FIRST REPORT

Contractor

SE SW NE


SECTION PLAT

_____ Ft. from N. Line

330 Ft. from S. Line

_____ Ft. from E. Line

990 Ft. from W. Line

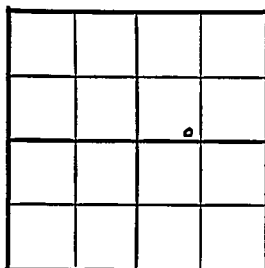

Rooks County

Location X

Rig up _____

Drilling and Remarks: _____

RECORD

Cased _____ in., _____ ft.

Sand _____

Gas _____

Oil _____

Total Depth _____

PRODUCTION

1st 24 hrs. Nat. _____

1st 24 hrs. after shot _____

Gas _____ Cu. Ft.

Dry Hole _____

Abandoned _____

Date

MAR 23 1949

19

S. J. LEWIS

Scout

Map No. KIA Sec. 11 Twp. 9 R. 17W

Well No. 1 Westhusin "C"

Harbar Company

COMPLETE

Contractor

SE SW NE, 1

E 11995


SECTION PLAT

 Ft. from N. Line

330 Ft. from S. Line

 Ft. from E. Line

990 Ft. from W. Line

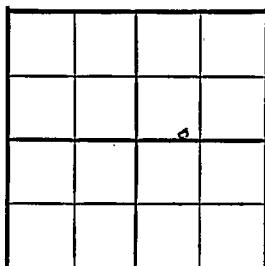

Rooks County

Location

Rig up

Drilling and Remarks:

Cor 8410 "
5" 08410 "
Run 50 oil Box

27-28

RECORD

Cased in., ft.

Sand

Gas

Oil

Total Depth 3414

PRODUCTION

1st 24 hrs. Nat.

1st 24 hrs. after shot

Gas Cu. Ft.

Dry Hole

Abandoned

Date

MAY 11 1949

19

S. I. LEWIS

Scout