


Section 11 Township 9 Range 17-W

Well No. #7 Westhusin

Company Plain Stock & White Eagle

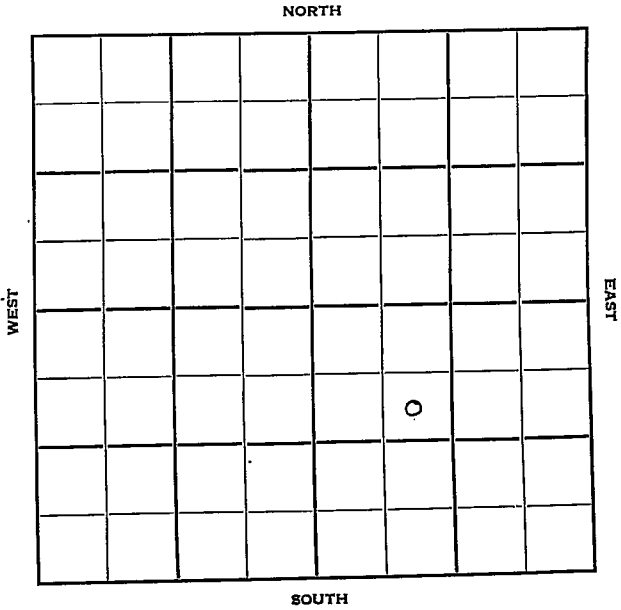

Sec. 11 Twp. 9 R. 17-W

Well No. #7 Westhusin Farm

Plain Stock & White Eagle Company

Contractor


990 Ft. from N. Line

\_\_\_\_\_ Ft. from S. Line

\_\_\_\_\_ Ft. from E. Line

990 Ft. from W. Line

SE NW SE

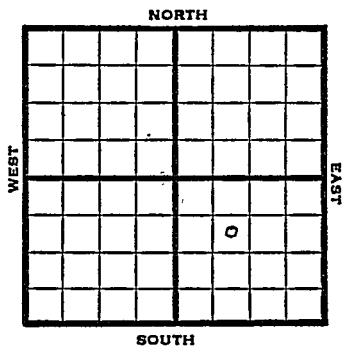

1950 Elev 2016

REPORT

6/7 Spud 5-16-50  
 10" @ 307  
 Lans 3138  
 Arb 3417-19  
 7" @ 3717  
 S/5 BOPH POP

8/9 10" @ 307  
 Lans 3138 Arb 3417-19 TD  
 7" @ 3417  
 S/5 boph P/40 bopd  
 Comp 124 bopd 5% wtr  
 Completed

**COMPLETED**

Map No. \_\_\_\_\_ Sec. 11 Twp. 9 R. 17WWell No. 7 WesthusinPlain Stock & White Eagle Company

Contractor

SE NW SE

E1.2016  
SECTION PLAT990 Ft. from N. Line

\_\_\_\_\_ Ft. from S. Line

\_\_\_\_\_ Ft. from E. Line

990 Ft. from W. Line

FIRST REPORT			
		0	

Rocks \_\_\_\_\_

Location \_\_\_\_\_

Rig up \_\_\_\_\_

## Drilling and Remarks:

Spud 5-16-50

10" @ 307

Lans. 3138

Arb. 3417-19

7" @ 3717

S/5 BOPH POP

## RECORD

Cased \_\_\_\_\_ in., \_\_\_\_\_ ft.

Sand \_\_\_\_\_

Gas \_\_\_\_\_

Oil \_\_\_\_\_

Total Depth \_\_\_\_\_

## PRODUCTION

1st 24 hrs. Nat. \_\_\_\_\_

1st 24 hrs. after shot \_\_\_\_\_

Gas \_\_\_\_\_ Cu. Ft.

Dry Hole \_\_\_\_\_

Abandoned \_\_\_\_\_

Date

JUN 7 1950

19

J. E. TYRA Scout

