


KANSAS Rooks

Section 11 Township 9 Range 17W

Well No. 2 Westhusin "A"

Company Delta & Harbar

Westhusin Pool
NORTH

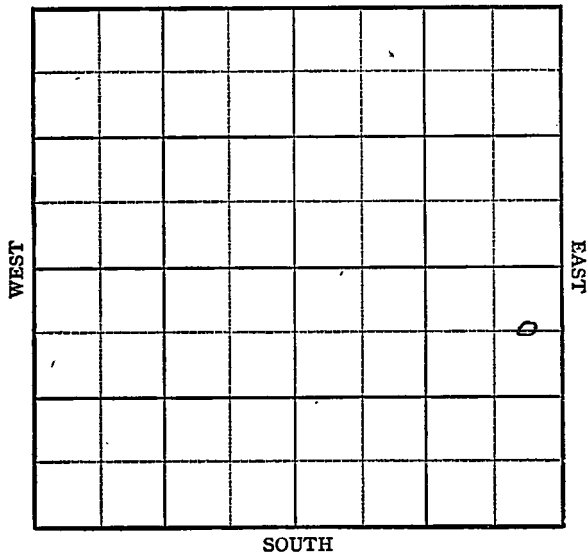

SOUTH

KANSAS

Rooks

Sec. 11 Twp. 9 R. 17W

Well No. #2 Westhusin "A" Farm _____

Delta & Harber Company

Westhusin Pool


660' Ft. from N. Line

_____ Ft. from S. Line

330' Ft. from E. Line

_____ Ft. from W. Line

C E L N E S E

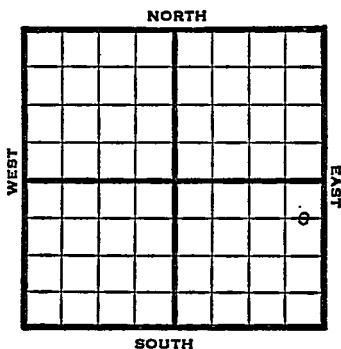

1949 Elev. 2020' **R E P O R T**

- 1/12 8" @ 98'
- 1/19 Drlg. 1900'
- Arb. 3424-25'
- TD 3425'
- Run 5"
- 1/26 Arb. 3420-25'
- TD 3425'
- 5"@ 3418'
- 2/2 "
- 2/9 Arb. 3420-25'
- TD 3425'
- 5"@ 3418'
- 2/16 Arbuckle 3420'
- 5" @ 3418'
- 250 acid
- Echo Pot. 1881 oil
- Gr. 37°
- TD 3425'

COMPLETED

Map No. _____ Sec. 11 Twp. 9 R. 17W

Well No. 2 Westhusin "A"

Delta & Harbor Company

FIRST REPORT Contractor
C E L N E S E

SECTION PLAT

660 Ft. from N. Line

_____ Ft. from S. Line

330 Ft. from E. Line

_____ Ft. from W. Line

			o

Rooks County

RECORD

Location _____

Cased _____ in., _____ ft.

Rig up _____

Sand _____

Drilling and Remarks:

Gas _____

8" @ 98

Oil _____

drlg. 1900

Total Depth _____

PRODUCTION

1st 24 hrs. Nat. _____

1st 24 hrs. after shot _____

Gas _____ Cu. Ft.

Dry Hole _____

Abandoned _____

Date

JAN 12 1949 19

S. J. LEWIS Scout

Kans^{as}Map No. R64 Sec. 11 Twp. 9 R. 17WWell No. 2 Westhusin "A"Delta & Harbar Company**COMPLETE**

Contractor

C E L N E S E

E. 12020
SECTION PLAT660 Ft. from N. Line Ft. from S. Line330 Ft. from E. Line Ft. from W. Line

Rooks County

			0

Location _____

Rig up _____

Drilling and Remarks:

See 73420
5' Oil 418'
250 acid
Ech to 1880'
379

RECORD

Cased _____ in., _____ ft.

Sand _____

Gas _____

Oil _____

Total Depth 3425'**PRODUCTION**

1st 24 hrs. Nat. _____

1st 24 hrs. after shot _____

Gas _____ Cu. Ft.

Dry Hole _____

Abandoned _____

Date

FEB 16 1949 19S. J. LEWIS Scout.