

Section 11 Township 9- Range 18-WWell No. #1 WilsonCompany Tom Palmer et al

NORTH

WEST

0							

EAST

SOUTH

Sec. 11 Twp. 9 R. 18W

Well No. #1 Wilson Farm

Tom Palmer et al Company

Pickrell Drlg. -Contr. Contractor

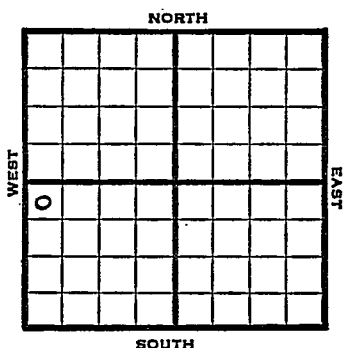
Wildcat
330' Ft. from N. Line

 Ft. from S. Line

 Ft. from E. Line

330' Ft. from W. Line

NW NW SW



1950

Elev. 2055' REPORT

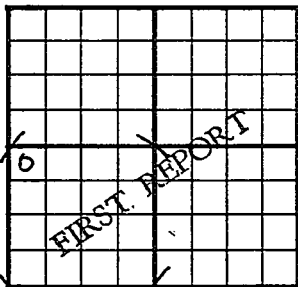
10/4

Spud 10-1-50
8" @ 132'
Drlg. 1350'

10/11

Spud 10-1-50
D&A TD 3625'
8" @ 132'
Heeb. 3208' Lans. 3245'
DST 3317-50 opn $\frac{1}{2}$ hr
Rec. 300' sw
Cong. 3512' Arb. 3576' TD 3625'

ABANDONED

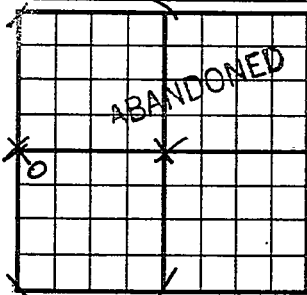
County Rooks State KansasSec. 11 (Blk. 9 (Sur. 18W Map No. 18W)
(Twp.)Operator Tom Palmer et al.Well No. 1 Farm WilsonElev. Location NE 1/4 Sec 11 Twp. 9 S. R. 18W330 Ft. From N Line SW330 Ft. From W Line Quarter1st. Report OCT 4 1950

Completion

Remarks

Pickrell Drlg. - Contr.Spudding Date 10-1-50Drlg. Data Wildcat8" @ 132. drlg. 1350

J. E. TYRA

County _____ Rocks _____ State KansasSec. 11 (Blk.
Twp.) 9 (Sur.
Rge.) 18W Map No. _____Operator Tom Palmer etal.Well No. 1 Farm WilsonElev. 2055 Location NW NW SW330 Ft. From N Line SW330 Ft. From W Line Quarter

1st. Report _____

Completion OCT 11 1950Remarks WildcatPickrell Drlg. - Contr.Spudding Date 10-1-50Drlg. Data D & A TD 36258" @ 132 Heeb. 3208 Lans. 3245DST 3317-50 open $\frac{1}{2}$ hr. Rec. 300' swCong. 3512 Arb. 3576 TD 3625D & A

J. E. TYRA