

KANSAS

FORM 51 5M 1-42 PETROL

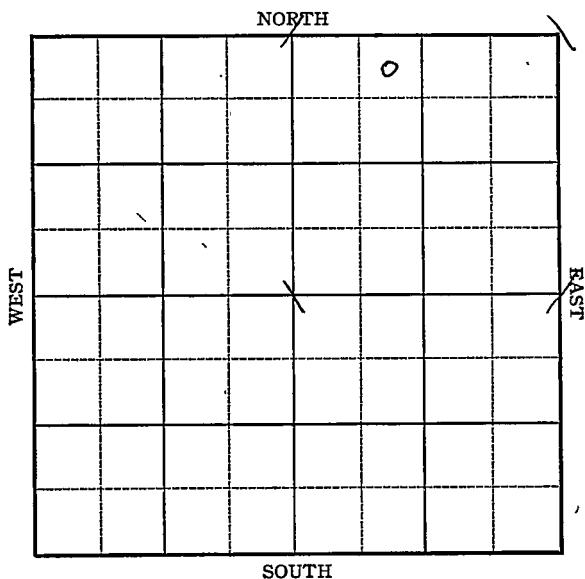
Rooks

Section 11 Township 9 Range 19-W

Well No. #2 Barry

Company Continental

5

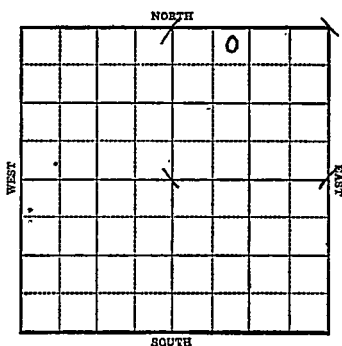


KANSAS

Rooks

Sec. 11 Twp. 9 R. 19-WWell No #2 Barry FarmContinental Company

Barry

330 Ft. from N. Line Ft. from S. Line Ft. from E. Line990 Ft. from W. Line*Elv. 2030*

1943

R E P O R T

4/28 Derrick.

5/5 10" @ 241'
Drlg. 1836'5/12 T.D. 3382'
Fsg.

5/29 "

5/26 To set whipstock at 1978'

6/2 Drlg. 2150'

6/9 Drlg. 3180'

6/16 Arb 3465-68 T.D.
6" @ 3466 Rust

6/23 3470-800' oil 6 hrs.

6/30 Arb. 3465
6" @ 3466'
T.D. 3473'
1500 acid
Pump 700 Pot.
Gravity 25.8**COMPLETED**

KANSAS

Rooks

Map No. 65 Sec. 11 Twp. 9 R. 19WWell No. 2 Barry

Continental

Company

FIRST REPORT

Contractor

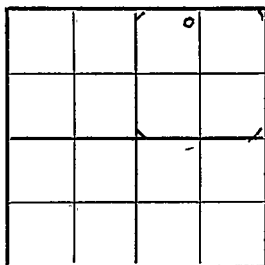
NE NW NE

SECTION PLAT

330 Ft. from N. Line

Ft. from S. Line

Ft. from E. Line

990 Ft. from W. Line

BARRY POOL

Location

Rig up

Drilling and Remarks:

Derrick

RECORD

Cased _____ in., _____ ft.

Sand _____

Gas _____

Oil _____

Total Depth _____

PRODUCTION

1st 24 hrs. Nat. _____

1st 24 hrs. after shot _____

Gas _____

Cu. Ft. _____

Dry Hole _____

Abandoned _____

Date

APR 28 1943 19

S. J. LEWIS

Scout

Rooks

KANSAS

Map No. 65 Sec. 11 Twp. 9 R. 19WWell No. 2 BarryContinental

Company

COMPLETED

Contractor

NE NW NE

330 Ft. from N. Line Ft. from S. Line Ft. from E. Line990 Ft. from W. Line

SECTION PLAT

		0	

BARRY POOLLocation Rig up

Drilling and Remarks:

Core 34656" @ 34661500 acidPump 700 P.S.258 ft.

RECORD

Cased in., ft.Sand Gas Oil Total Depth 2473

PRODUCTION

1st 24 hrs. Nat. 1st 24 hrs. after shot Gas Cu. Ft.Dry Hole Abandoned

Date

JUN 30 1943

19

S. J. LEWIS Scout