KANSAS

FORM 51 5M 10-41 PETROL

Rooks


Section 11 Township 9 Range 19-W

Well No. #1 ~~Berry~~ Barry

Company Continental

(Was drilled as #2 Stratigraph)

Wildcat test.

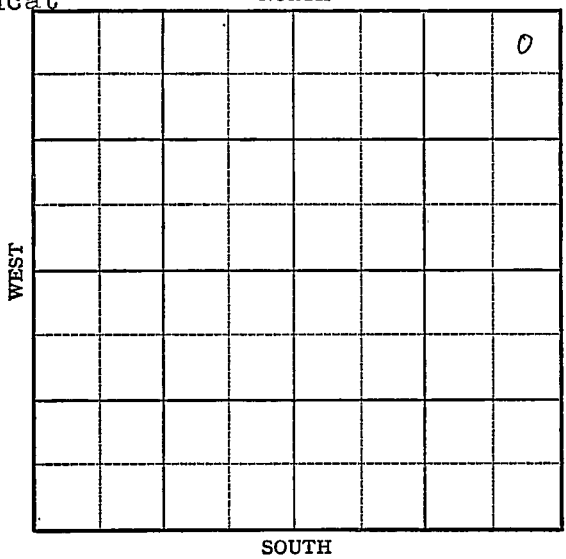

Form 252-A
5M 5-42 Petrol

Rooks KANSAS

Sec. 11 Twp. 9 R. 19-W

Well No. #1 ~~Berry~~ Barry Farm

Continental Company

(Was drilled as #2 Stratigraph Test.


(Wildcat)

330 Ft. from N. Line

Ft. from S. Line

330 Ft. from E. Line

Ft. from W. Line

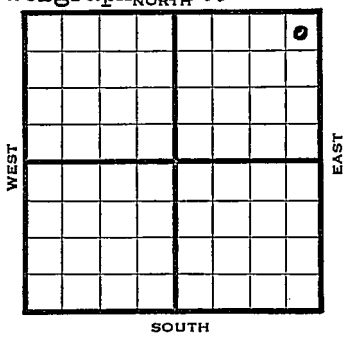

2017

1942	Elev. ~~XXXX~~ REPORT
8/12	Anhy. 1392 Topeka 2950 Lansing 3189 Arbuckle 3435 2300' oil ½ hour T.D. 3460'
8/19	8" - 170 6" - 3431 Gravity 25.8
8/27	Swab 45 oil in 1/3 hr.
9/2	Shut down for tanks
9/9	" "
9/16	" "
9/23	" "
9/30	" "
10/7	Arb. 3435' 6" - 3431 Depth Pot. 28956 Max 3000 TD 3460 Gravity 25.8

COMPLETED

Form 26 200 Bks. 5-41 McW.

Rooks KANSAS

Map No. 65 Sec. 11 Twp. 9 R. 19W

Well No. 1 Berry

Continental Company

(Was drilled as #2 Stratigraph Contractor

FIRST REPORT test

NE/Cor.

330 Ft. from N. Line


____ Ft. from S. Line

330 Ft. from E. Line

____ Ft. from W. Line

Wildcat

SECTION PLAT

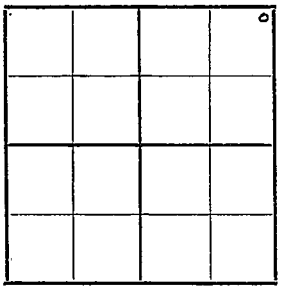

Location ____

Rig up ____

Drilling and Remarks:

Anhy. 1392
Topeka 2950
Lansing 3189
Arbuckle 3435
2300' oil ½hour

RECORD

Cased ____ in., ____ ft.

Sand ____

Gas ____

Oil ____

Total Depth 3460

PRODUCTION

1st 24 hrs. Nat. ____

1st 24 hrs. after shot ____

Gas ____ Cu. Ft.

Dry Hole ____

Abandoned ____

Date AUG 19 1942

19 ____

S. J. LEWIS Scout

Form 26 200 Bks. 5-41 McW.

Rooks

Map No. 65 Sec. 11 Twp. 9 R. 19W

Well No. 1 Barry

Continental Company

CORRECTION Contractor

NE/C

330 Ft. from N. Line


Ft. from S. Line

330 Ft. from E. Line

Ft. from W. Line

BARRY POOL

SECTION PLAT

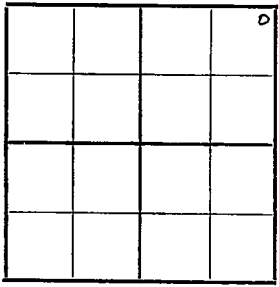

Location

Rig up

Drilling and Remarks:

Reported as
#1 Berry

RECORD

Cased in., ft.

Sand

Gas

Oil

Total Depth

PRODUCTION

1st 24 hrs. Nat.

1st 24 hrs. after shot

Gas Cu. Ft.

Dry Hole

Abandoned

Date

SEP 2 1942 19 S. J. LEWIS Scout

Form 26 200 Bks 5-42 Petrol

Rooks KANSAS

Map No. 65 Sec. 11 Twp. 9 R. 19W


Well No. 1 Barry

Continental Company

COMPLETED Contractor

NE/C (Was drilled as #2 Stratigraphic test)

SECTION PLAT

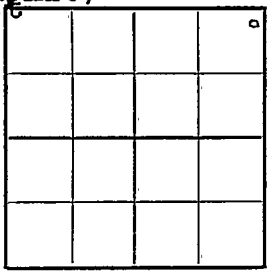

330 Ft. from N. Line

Ft. from S. Line

330 Ft. from E. Line

Ft. from W. Line

BARRY POOL

Location

Rig up

Drilling and Remarks:

Ar & 3435-

6" C 3431

Dept to Pay 2895'

Map 3000

25-8E Gr/

RECORD

Cased in., ft.

Sand

Gas

Oil

Total Depth 3460

PRODUCTION

1st 24 hrs. Nat.

1st 24 hrs. after shot

Gas Cu. Ft.

Dry Hole

Abandoned

Date

OCT 7 1942

19

S. J. LEWIS Scout