


Company Continental 3

2

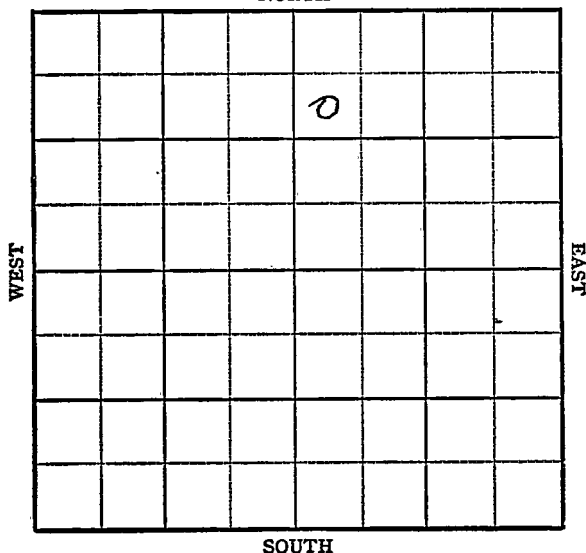

KANSAS

Rooks

Sec. 11 Twp. 9 R. 19W ✓

Well No. #3 Barry Farm

Continantal

Barry Pool Company


990' Ft. from N. Line

 Ft. from S. Line

 Ft. from E. Line

330' Ft. from W. Line

SW NW NE

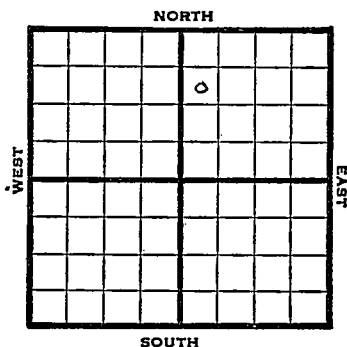

1948

Eli 2004'

R E P O R T

9/29

Derrick

10/6

10" @ 212'
Drlg 1928'

10/13

Drlg 3395'

10/19

Arb. 3430'
6" @ 3431'
TD 3437
500 acid
Swb 2 bbls oil PH 10 hrs.

10/27

TD 3441'
Arb 3430
6" @ 3431'
1500 acid
Pump 162 Oil Pot
272 Gr.
Comp

COMPLETED

Map No. _____ Sec. 11 Twp. 9 R. 19W

Well No. 3 Barry

Continental Company

FIRST REPORT Contractor

SW NW NE

SECTION PLAT

990 Ft. from N. Line

_____ Ft. from S. Line

_____ Ft. from E. Line

330 Ft. from W. Line

		o	

Rooks County

Location _____

Rig up _____

Drilling and Remarks:

Derrick

RECORD

Cased _____ in., _____ ft.

Sand _____

Gas _____

Oil _____

Total Depth _____

PRODUCTION

1st 24 hrs. Nat. _____

1st 24 hrs. after shot _____

Gas _____ Cu. Ft.

Dry Hole _____

Abandoned _____

Date

SEP 29 1948 19 S. J. LEWIS Scout

Barry Pool

Map No. 65 Sec. 11 Twp. 9 R. 19W

Well No. 3 Barry

Continental Company

COMPLETE

Contractor

SW NW NE

E12004
SECTION PLAT

990 Ft. from N. Line

_____ Ft. from S. Line

_____ Ft. from E. Line

330 Ft. from W. Line

Rooks County

Location _____

Rig up _____

Drilling and Remarks:

Art 3430

6" @ 3431

1500 acid

Pump 162 oil Pot

27 1/2 in

RECORD

Cased _____ in., _____ ft.

Sand _____

Gas _____

Oil ☒

Total Depth 3441

PRODUCTION

1st 24 hrs. Nat. _____

1st 24 hrs. after shot _____

Gas _____ Cu. Ft.

Dry Hole _____

Abandoned _____

Date

OCT 27 1948 19

S. J. LEWIS Scout