


Section 11 Township 9 Range 19WWell No. #5 BerryCompany Continental

NORTH

WEST

EAST

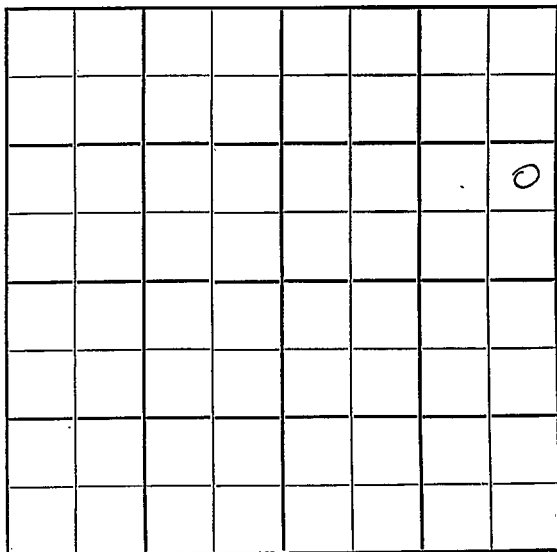

SOUTH

Rooks KANSAS

Sec. 11 Twp. 9 R. 19W

Well No. #5 Berry Farm

Continental Company

Harbar Drlg. - Contr. Contractor

Berry Pool


 Ft. from N. Line

990' Ft. from S. Line

330' Ft. from E. Line

 Ft. from W. Line

NE SE NE

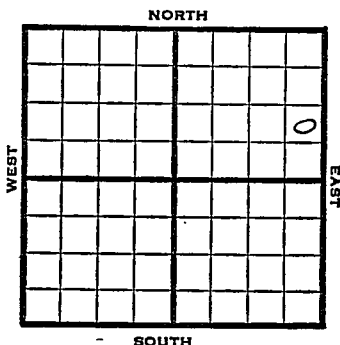

1950 Elev. 2043' REPORT

12/6 Spud 12-1-50
10 @ 216'
Anhy 1410
Drlg. 2358'

12/27 Spud 12-1-50
Oil Well TD 3465
10" @ 3459' TD 3462
7" @ 3460 FU 100' oil 1½ hr
DD 3464 FU 2000' oil 8 hr
DD 3465 S/20 boph 500 A
EPI 3000 bopd

COMPLETED

Sec. **11** (Blk. **9** (Sur. **19W** Map No.

Well No. **5** Farm **Berry**

Elev.	Location	NE	SE	NE
-------	----------	----	----	----

0

FIRST REPORT

330 Ft. From E Line Quarter

1st. Report DEC 6 1950

Completion _____

Remarks


Harbar Drlg. - Contr.

Spudding Date 12-1-50

Drlg. Data	Berry Pool
------------	------------

10" @ 216 Anhy 1410 drlg. 2356

County _____ Rooks _____ State Kansas
 Sec. 11 (Blk. 9) (Sur. 19W) (Twp.) _____ Map No. _____
 Operator Continental
 Well No. 5 Farm Berry
 Elev. 2043 Location NE SE NE

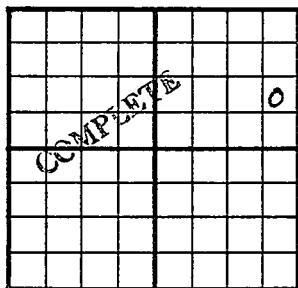

990 Ft. From S Line NE
330 Ft. From E Line Quarter
 1st. Report _____
 Completion DEC 27 1950
 Remarks Berry Pool
Harbar Drlg. - Contr.
 Spudding Date 12-1-50

Drlg. Data Oil well TD 3465
10" O 216 Anhy 1410 Lans. 3214
Arb. 3459 TD 3462 7" O 3460
FU 100' oil 1 $\frac{1}{2}$ hr. DD 3464 FU 2000'
oil 8 hr. DD 3465 S/ 20 boph 500 A
EPI 3000 bopd

J. E. TYRA