KANSAS
FORM 51 5M PETROL


Rooks

Section 11 Township 9 Range 19W

Well No. #2 Hederhorst

Company Continental

4

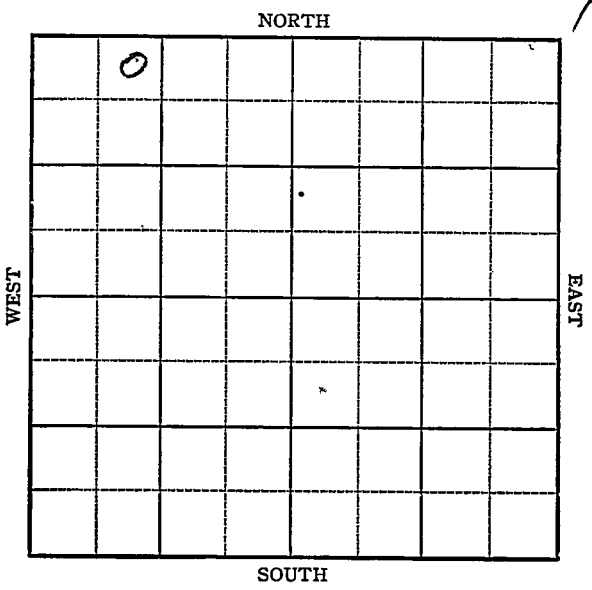

FORM 252-A
5M 3-44 PETROL

Rooks

Sec. KANSAS Twp. 9 R. 19W

Well No. #2 Hederhorst Farm

Continental Company

Barry


330 Ft. from N. Line

_____ Ft. from S. Line

_____ Ft. from E. Line

990 Ft. from W. Line

Elev. 2028

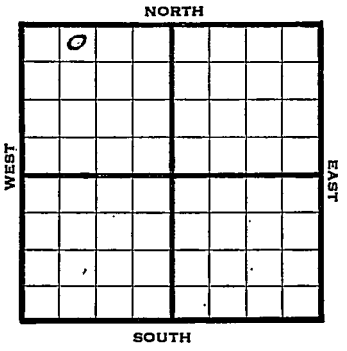

1944	REPORT
5/3	Location
5/10	"
5/17	"
5/24	Derrick
5/31	"
6/7	10" @ 240 Drlg. 1035.
6/15	2840 fishing
6/21	Drlg. 3700
6/28	Lans 3199 Arb 3506 SO 3264-85, 3370-3404 TD 3566 6" @ 3565 RUST

OVER

1944

7/12 Lans 3199
Arb 3506
6" @ 3565
Perf Lans.
2000 Acid
Pump 1166 Pot
Gravity 31.0
TD 3566

COMPLETED

FORM 26 200 BKS 2-44 PETROL

KANSAS

Pool Name Barry

Map No. 65 Sec. 11 Twp. 9 R. 19W


Well No. 2 Hederhorst

Continental Company

FIRST REPORT Contractor

NE NW NW

SECTION PLAT

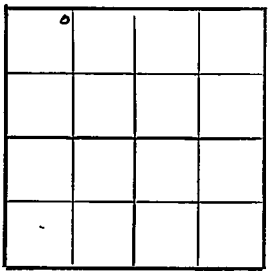

330 Ft. from N. Line

____ Ft. from S. Line

____ Ft. from E. Line

990 Ft. from W. Line

Rooks County

Location X

Rig up

Drilling and Remarks:

RECORD

Cased ____ in., ____ ft.

Sand

Gas

Oil

Total Depth

PRODUCTION

1st 24 hrs. Nat.

1st 24 hrs. after shot.

Gas ____ Cu. Ft.

Dry Hole

Abandoned

Date

MAY 3 1944 19 S. J. LEWIS Scout

FORM 26 200 BKS. 2-44 PETROL

Pool Name Barry

KANSAS

Map No. 6 Sec. 11 Twp. 9 R. 19W


Well No. 2 Hederhorst

Continental Company

COMPLETED Contractor

NE NW NW

SECTION PLAT

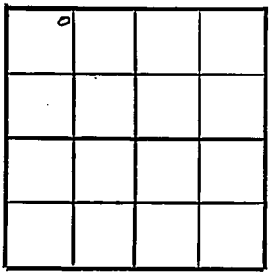

330 Ft. from N. Line

_____ Ft. from S. Line

_____ Ft. from E. Line

990 Ft. from W. Line

Rooks County

Location

Rig up

Drilling and Remarks:

Lans 3199
Cer @ 3506
6" @ 3565
Perf Lans.
2000 acid
Pump. 1166 Pf
31° Gr

RECORD

Cased ____ in., ____ ft.

Sand

Gas

Oil

Total Depth 3566

PRODUCTION

1st 24 hrs. Nat.

1st 24 hrs. after shot

Gas ____ Cu. Ft.

Dry Hole

Abandoned

Date

JUL 12 1944 19

S. J. LEWIS Scout