

Section 11 Township 9 Range 19-W

Well No. #1 Ruder

Company B & B et al

16

NORTH

WEST

EAST

							0

SOUTH

Sec. 11 Twp. 9 R. 19W

Well No. #1 Ruder Farm

B & B et al Company

Contractor


Ft. from N. Line

330' Ft. from S. Line

330' Ft. from E. Line

Ft. from W. Line

SE SE SE

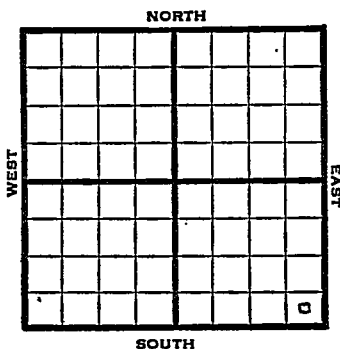

1950

Elev 2056

REPORT

5/24 Spud 5-20-50
8" @ 157'
Drlg. 1410'

6/28 8" @ 157
Anhy 11438 Heeb 3207
Lans 3247 Arb 3486-88 SO
5 1/2" @ 3487
TD 3492
300 acid
S/3 boph
Comp 120 bopd 32% wtr
Completed

COMPLETED

Kansas

Map No. _____ Sec. 11 Twp. 9 R. 19W

Well No. 1 Ruder

B & B et al Company

Contractor

SE SE SE

_____ Ft. from N. Line

330 Ft. from S. Line

330 Ft. from E. Line

_____ Ft. from W. Line

SECTION PLAT



Rooks

Location _____

Rig up _____

Drilling and Remarks:

Spud 5-20-50

8" @ 157

Drlg. 1410

RECORD

Cased _____ in., _____ ft.

Sand _____

Gas _____

Oil _____

Total Depth _____

PRODUCTION

1st 24 hrs. Nat. _____

1st 24 hrs. after shot _____

Gas _____ Cu. Ft.

Dry Hole _____

Abandoned _____

Date

MAY 24 1950 19

J. E. TYRA Scout

Map No. _____ Sec. 11 Twp. 9 R. 19WWell No. 1 RuderB & B et al.

Company

Contractor

SE SE SE


E1. 2056
SECTION PLAT

_____ Ft. from N. Line

330 Ft. from S. Line330 Ft. from E. Line

_____ Ft. from W. Line

Rooks County

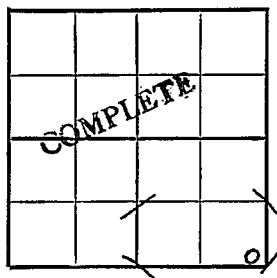

Location _____

Rig up _____

Drilling and Remarks:

8" \odot 157

Anhy 1438

Heeb. 3207

Lans. 3247

Arb. 3486-88 \$0

5 $\frac{1}{2}$ " \odot 3487

TD 3492

RECORD

Cased _____ in., _____ ft.

Sand _____

Gas _____

Oil _____

Total Depth 3492

PRODUCTION

1st 24 hrs. Nat. _____

1st 24 hrs. after shot _____

Gas _____ Cu. Ft.

Dry Hole _____

Abandoned _____

Date

JUN 28 1950 19J. E. TYRA Scout

300 acid

S/ 3 boph

Comp. 120 bopd

.....	Misc.
.....	Pierce Map
.....	France Map
.....	Tracings
.....	Land Wall Map
.....	Land Small-Map
.....	Scout Cards

F.C.

JUL 3 1950

JUL 3 1950

.....

.....

