

Section 11 Township 9 KANSAS Range 19WWell No. #1 RudderCompany Fred Drlg.

NORTH

							0

SOUTH

EAST

WEST

9

Rooks

KANSAS

Sec. 11 Twp. 9 R. 19 W ✓

Well No. # 1 Rudder Farm

Fred Drlg. Company

Contractor


330 Ft. from N. Line

Ft. from S. Line

330 Ft. from E. Line

Ft. from W. Line

NE NE SE

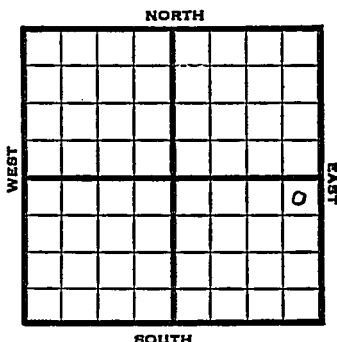

1951

Elev. 2060' REPORT

5/9 Cellar & pits

5/23 Spud 5-8-51
D & A TD 3576' 8" @ 139
Anhy 1438' Top. 3013' Heeb 3224'
Lans. 3264' B KC 3490' Cong 3514'
Simp. 3529' Arb. 3565'
TD 3576' D & A


ABANDONED

County Rooks State Kansas
 Sec. 11 (Blk. 4) (Sur. 9) 19W Map No.

Operator Fred Drlg.

Well No. 1 Farm Rudder

Elev. Location NE NE SE

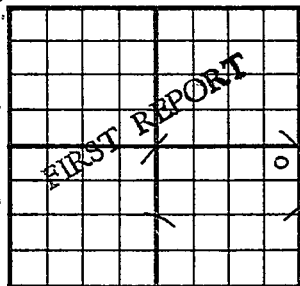

330 Ft. From N Line SE

330 Ft. From E Line Quarter

1st. Report MAY 9 1951

Completion


Remarks

Spudding Date

Drlg. Data

Cellar & pits

J. E. TYRA

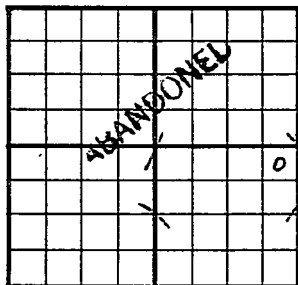County _____ Rocks _____ State KansasSec. 11 (Blk. Twp.) 9 (Sur. Rge.) 19W Map No. _____Operator Fred Drlg.Well No. 1 Farm RudderElev. 2060 Location NE NE SE330 Ft. From N Line SE330 Ft. From E Line Quarter

1st. Report _____

Completion MAY 23 1951

Remarks _____

Spudding Date 5-8-51Drlg. Data D & A TD 35768" @ 139 Anky 1438 Top. 3013Heeb. 3224 Lans. 3264 B KC 3490Cong. 3514 Simp. 3529 Arb. 3565TD 3576 D & A