


Section 11 Township 9 Range 19WWell No. #6 Dan BerryCompany Continental Oil21

NORTH

WEST

EAST

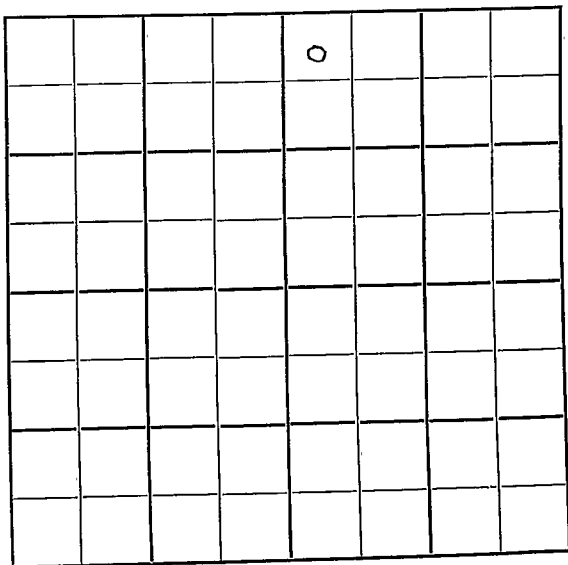

SOUTH

Rooks

KANSAS

Sec. 11 Twp. 9 R. 19W

Well No. #6 Dan Berry Farm

Continental Oil Company

Braden Drlg. -Contr. Contractor

Berry Pool


330' Ft. from N. Line

Ft. from S. Line

Ft. from E. Line

330' Ft. from W. Line

NW NW NE

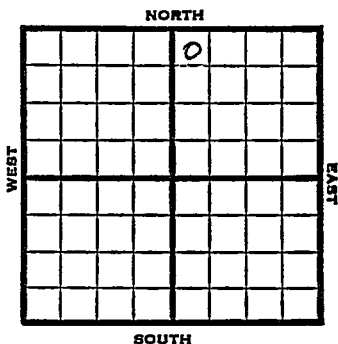

1951

Elev. 2000'

REPORT

8/22

Spd 8-17-51
10" @ 196
Drlg. 2240

11/21

Spud 8-17-51
Oil well TD 3423' 10" @ 196
Lans. 3177'
DST 3244-64' open 15 min. rec 400' salt water.
DST 3312-37 open $\frac{1}{2}$ hr. rec 31' OCM
DST 3312-67 open 1 hr. rec 60' HOCM
Arb. 3420-23' 5" @ 3421' PB 3416
CO to 3420' 24/3366-74 B/ $\frac{1}{2}$ GO $\frac{1}{2}$ GWPI
30/3330-50 no inc. PB 3416 1000 A
S/5 BOPH S/72 BO 18 hr. S/3 $\frac{1}{2}$ BOPH
Comp/ 133 BOPD

COMPLETED

County Rooks State Kansas
 Sec. 11 (Blk.) 9 (Sur. Rge.) 19W Map No.
 Operator Continental Oil
 Well No. 6 Farm Dan Berry
 Elev. _____ Location NW NW NE

330 Ft. From N Line NE

330 Ft. From W Line Quarter

1st. Report AUG 22 1951

Completion

Remarks

Braden Drlg. - Contr.

Spudding Date 8-17-51


Drlg. Data

Berry Pool

10th @ 196 drlg. 2240

J. E. TYRA

County _____ Rocks _____ State Kansas
 Sec. 11 (Blk. Twp.) 9 (Sur. Rge.) 19W Map No. _____
 Operator Continental Oil
 Well No. 6 Farm Dan Berry
 Elev. 2000 Location NW NW NE

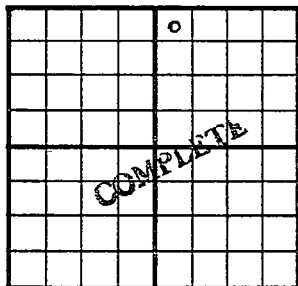

330 Ft. From N Line NE
330 Ft. From W Line Quarter
 Ist. Report _____
 Completion NOV 21 1951
 Remarks Berry Pool
Braden Drlg. - Contr.
 Spudding Date 8-17-51

Drlg. Data Oil well TD 3423
10" @ 196 Lans. 3177 DST 3244-64
open 15 min. Rec. 400' salt water
DST 3312-37 open $\frac{1}{2}$ hr. Rec. 31' ocm
DST 3312-67 open 1 hr. Rec. 60' hocm
Arb. 3420-23 5" @ 3421 PB 3416 CO to
3420 24/ 3366-74 B/ $\frac{1}{2}$ go $\frac{1}{2}$ gwph
30/ 3330-50 no inc. PB 3416 1000 A
S/ 5 boph S/ 72 bo 18 hr. S/ $3\frac{1}{2}$ boph
Comp. 133 bopd

J. E. TYRA