

KANSAS


Rooks County

FORM 51 5M 6-46 PETROL

Section 11 Township 9 Range 19W

Well No. 3 Hederhorst

Company Continental

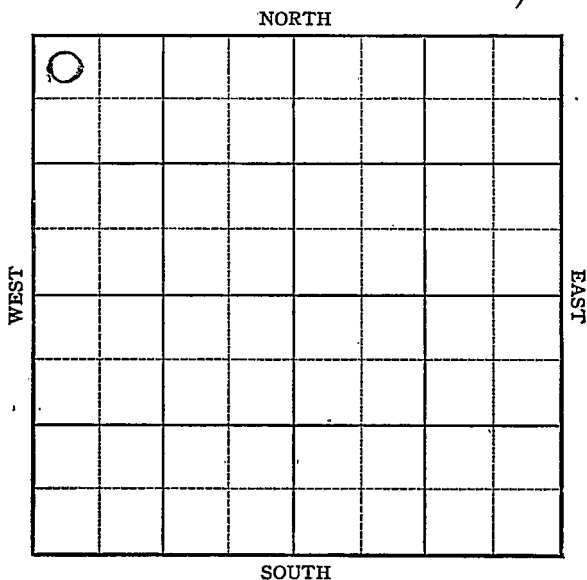

KANSAS

Rooks County



11

9

19W

Sec. _____ Twp. _____ R. _____

Well No. #3 Hederhorst Farm _____

Continental Company _____

Barry


330 Ft. from N. Line

_____ Ft. from S. Line

_____ Ft. from E. Line

330 Ft. from W. Line

NW/c

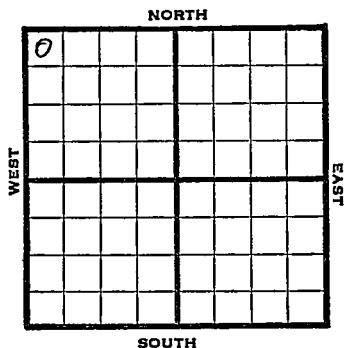

1946

2059

REPORT

8/7	Location
8/13	"
8/20	"
8/27	13" @ 250 WOC
9/5	2785' fsg
9/10	Lans 330'
	Arb 3471
	TD 3491
	Run 6"
9/18	6" @ 3479 RUST
9/24	Swb 40 oil PH 6 hrs
10/2	Arb 3471'
	6" @ 3479'
	Depth Pot 3000
	TD 3491'
	Grav 36

COMPLETED

KANSAS

Kansas

Pool Name BarryMap No. 65 Sec. 11 Twp. 9 R. 19WWell No. 3 HederhorstContinental Company

FIRST REPORT

Contractor

NW/C

SECTION PLAT

0			

330 Ft. from N. Line Ft. from S. Line Ft. from E. Line330 Ft. from W. LineRooks CountyLocation XRig up

Drilling and Remarks:

RECORD

Cased in., ft.Sand Gas Oil Total Depth

PRODUCTION

1st 24 hrs. Nat. 1st 24 hrs. after shot Gas Cu. Ft.Dry Hole Abandoned

Date

AUG 7 . 1946 19 S. J. LEWIS Scout

KANSAS Kansas Pool Name Barry Pool
 Map No. 62 Sec. 11 Twp. 9 R. 19W
 Well No. 3 Hederhorst

Continental Company

COMPLETED Contractor

NW/C

E12059
 SECTION PLAT

0			

330 Ft. from N. Line

 Ft. from S. Line

 Ft. from E. Line

330 Ft. from W. Line

Rooks County

Location

Rig up

Drilling and Remarks:

Per 3471

6' @ 3479

Dep. 110' @ 3480

36' @ 3482

RECORD

Cased in., ft.

Sand

Gas

Oil

Total Depth 3481

PRODUCTION

1st 24 hrs. Nat.

1st 24 hrs. after shot

Gas Cu. Ft.

Dry Hole

Abandoned

Date

OCT 2 1946 19

S. J. LEWIS Scout