

KANSAS

FORM 51 5M 11-44 PETROL


Rooks

Section 11 Township 9 Range 19W

Well No. 1 Ruder

Company Aylward Prod. et al

10

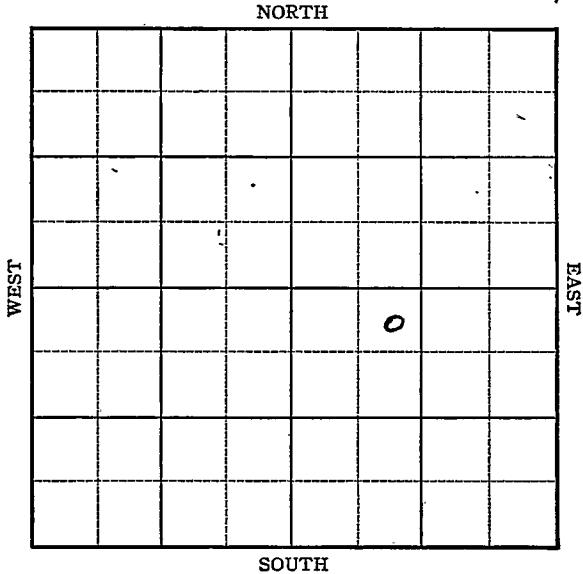



Sec. 11 Twp. 9 R. 19W

Well No. #1 Ruder Farm


Aylward Prod. et al Company

Barry'
330 Ft. from N. Line

_____ Ft. from S. Line

_____ Ft. from E. Line

990 Ft. from W. Line

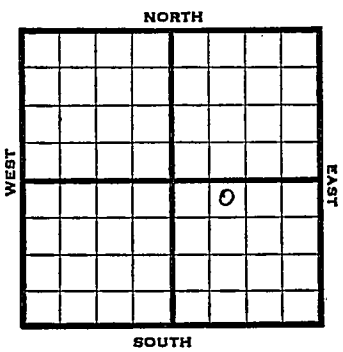

NE NW SE

1946

REPORT

5/22

Location

5/29

8" @ 298
Anhy. 1440
Drlg. 2350'

6/5

Lans. 3210
Arb. 3602
TD 3605'

ABANDONED

KANSAS

Kansas Pool Name Barry

Map No. 65 Sec. 11 Twp. 9 R. 19W

Well No. 1 Ruder

Aylward Prod. etal Company

Company

FIRST REPORT Contractor

Contractor

NE NW SE

SECTION PLAT

330 Ft. from N. Line

_____ Ft. from S. Line

_____ Ft. from E. Line

990 Ft. from W. Line

		o	

Rooks County

Location ✓

Rig up _____

Drilling and Remarks:

RECORD

Cased _____ in., _____ ft.

Sand _____

Gas _____

Oil _____

Total Depth _____

PRODUCTION

1st 24 hrs. Nat. _____

1st 24 hrs. after shot _____

Gas _____ Cu. Ft.

Dry Hole _____

Abandoned _____

Date

MAY 22 1946

19

S. J. LEWIS

Scout

KANSAS Kansas Pool Name Barry Pool
 Map No. 65 Sec. 11 Twp. 9 R. 19W

Well No. 1 Ruder

Aylward Prod. etal Company

ABANDONED

Contractor

NE NW SE

E. 2046
SECTION PLAT

330 Ft. from N. Line

_____ Ft. from S. Line

_____ Ft. from E. Line

990 Ft. from W. Line

		0	

Rooks County

Location _____

Rig up _____

Drilling and Remarks:

Louis 3210

Cor 83602

RECORD

Cased _____ in, _____ ft.

Sand _____

Gas _____

Oil _____

Total Depth 3605

PRODUCTION

1st 24 hrs. Nat. _____

1st 24 hrs. after shot _____

Gas _____ Cu. Ft.

Dry Hole _____

Abandoned _____

Date

JUN 5 1946 19

S. J. LEWIS Scout