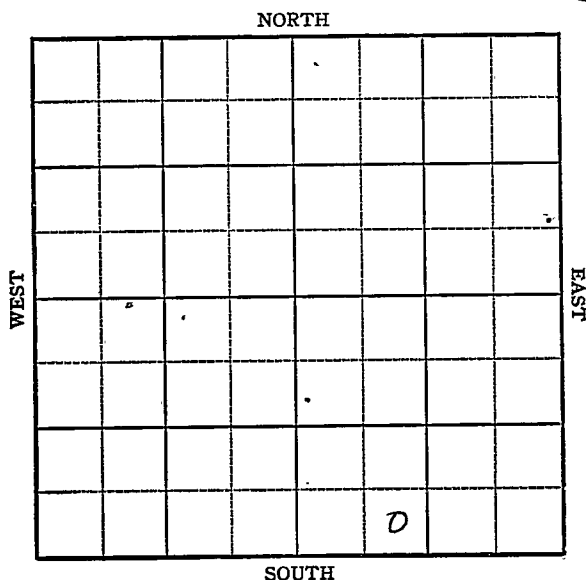


Rooks

KANSAS

Section 11 Township 9 Range 19WWell No. #2 RudderCompany Fred Drlg. B & B DRIg. 15

Rooks

KANSAS

Sec. 11 Twp. 9 R. 19W ✓

Well No. #2 Rudder Farm

~~Fred Drig.~~ B + B Drig. Company

Contractor


Ft. from N. Line

330' Ft. from S. Line

Ft. from E. Line

990' Ft. from W. Line

SE SW SE

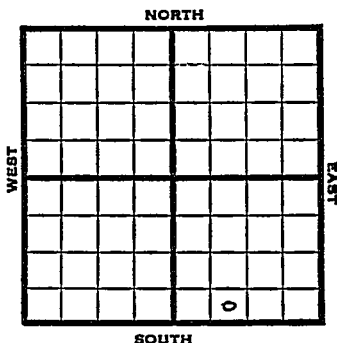

1951

Elev. 2042' REPORT

5/23

Spud 5-19-51
8" @ 220
Drig. 1296'

7/25

Spud 5-19-51
Oil well TD 3475'
8" @ 220' Anhy 1410' Heeb 3186'
Lans. 3226'
DST 3244-72 open 45 min. rec 292' SW
DST 3304-15 open 15 min. rec 297' SW
DST 3363-81 open 1 hr. rec 62' muddy SW
DST 3390-3405 open 20 min. rec 5' mud
Feb. 3472-74' 5" @ 3473 TD 3475
FU 250' oil 2 hr.
Comp. 79 BOPD 54% water

COMPLETED



Sec.	11	(Blk.) (Twp.)	9	(Sur.) (Rge.)	19W	Map No.
------	----	------------------	---	------------------	-----	---------

Well No. 2 Farm Budder

Elev.	Location	SP	SW	SE
-------	----------	----	----	----

330 Ft. From S Line SE

990 Ft. From W Line Quarter

1st. Report MAY 23 1951

Completion

Remarks


Spudding Date 5-19-51

Drig. Data

8" @ 220 drlg. 1296

J. E. TVRA

County _____ Rocks _____ State Kansas
 Sec. 11 (Blk.) 9 (Sur.) 19W Map No. _____
 Operator Fred Drlg. B + B Drlg.
 Well No. 2 Farm Rudder
 Elev. 2042 Location SE SW SE

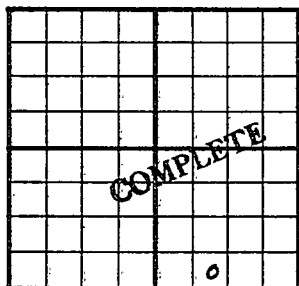

330 Ft. From S Line SE
990 Ft. From W Line Quarter
 Ist. Report _____
 Completion JUL 25 1951
 Remarks Berry Pool
 Spudding Date 5-19-51

Drig. Data Oilwell TD 3475
8" @ 220 Anhy 1410 Heeb. 3186
Lans. 3226 DST 3244-72 open 45 min.
Rec. 292' sw DST 3304-15 open 15 min.
Rec. 297' sw DST 3363-81 open 1 hr.
Rec. 62' muddy sw DST 3390-3405
open 20 min. Rec. 5' mud Arb. 3472-74
5" @ 3473 TD 3475 FU 250' oil 2 hr.
Comp. 79 bopd 54% water

J. E. TYRA