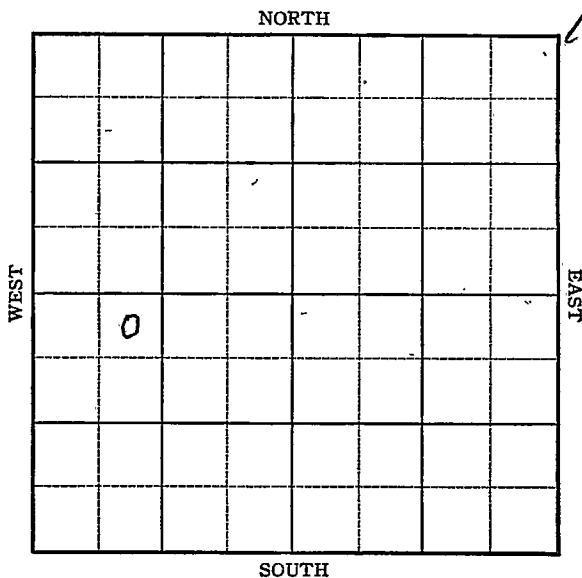


Section 11 Township 9 Range 19WWell No. 1 ThyfaultCompany Aylward et al

KANSAS

Sec. 11 Twp. 9 R. 19W

Well No. #1 Thyfault Farm

Aylward et al Company

Barry


330 Ft. from N. Line

Ft. from S. Line

Ft. from E. Line

990 Ft. from W. Line

NE NW SW

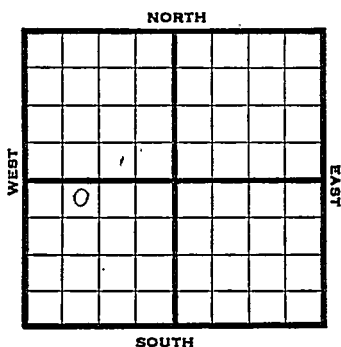

1946

Elev. 2049

R E P O R T

6/5 RUR
6/12 8" @ 290 anhy 1455
Drlg 2985'
6/18 Lans 3198
Arb 3532-
3563 TD
5" @ 3563 RUST
6/26 Lans 3198
Arb. 3532
5" @ 3563
Perf. Lans. 500 acid.
TD 3563'

ABANDONED

KANSAS

Kansas Pool Name BarryMap No. 5 Sec. 11 Twp. 9 R. 19WWell No. 1 ThyfaultAylward etal


Company

FIRST REPORT

Contractor

NE NW SW

SECTION PLAT

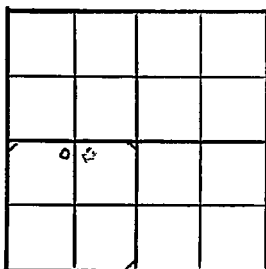330 Ft. from N. Line

Ft. from S. Line

Ft. from E. Line

990 Ft. from W. LineRooks County

Location

Rig up

Drilling and Remarks:

RUR

RECORD

Cased _____ in, _____ ft.

Sand _____

Gas _____

Oil _____

Total Depth _____

PRODUCTION

1st 24 hrs. Nat. _____

1st 24 hrs. after shot _____

Gas _____ Cu. Ft.

Dry Hole _____

Abandoned _____

Date

JUN 5 1946 19


S. J. LEWIS

Scout

KANSAS ~~Kansas~~ Pool Name Barry PoolMap No. 65 Sec. 11 Twp. 9 R. 19WWell No. 1 ThyfaultAylward et al Company

ABANDONED

NE NW SW Contractor

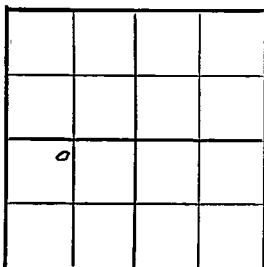E 1,2049
SECTION PLAT330 Ft. from N. Line Ft. from S. Line Ft. from E. Line990 Ft. from W. LineRooks County

Location

Rig up

Drilling and Remarks:

Lease 8198Ac 85325' @ 8563Perf lease.500 ac

RECORD

Cased in., ft.Sand Gas Oil Total Depth 3563

PRODUCTION

1st 24 hrs. Nat.1st 24 hrs. after shot.Gas Cu. Ft.Dry Hole Abandoned

Date

JUN 26 1946

19

S. J. LEWIS

Scout