


Section 11 Township 9 Range 19W

Well No. #1 Thyfault

Company Phillips

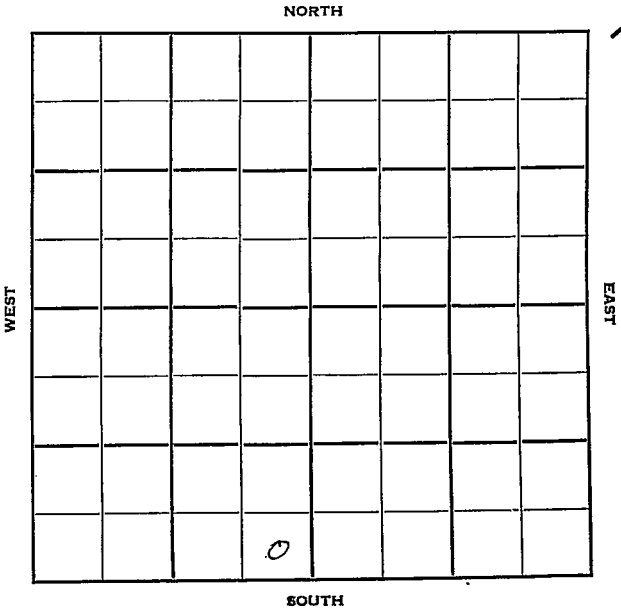

KANSAS

Rooks

✓

Sec. 11 Twp. 9 R. 19W

Well No. #1 Thyfault "A" Farm

Phillips Continental et al Company
Chandler Pool

 Ft. from N. Line


330'

 Ft. from S. Line

330' Ft. from E. Line

 Ft. from W. Line

SE SW

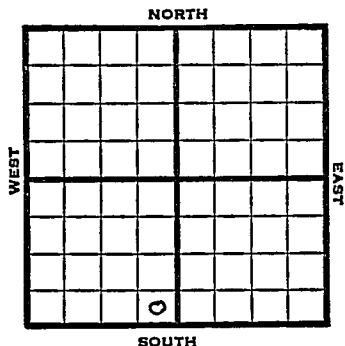

1949 Elev 2031' REPORT

4/27 10" @ 218'

WOC

5/4 Drlg 3355'

5/11 TD 3508'

Lans. 3220'

Arb. 3468'

Aband.

ABANDONED

O.W.D.B

1950

3/29 Arb. 3458'

TD 3508'

D&A

Drlg. deeper @ 3900 for SWD

*5-18-50
Dorothy write for
completion Ticket
same*

6/28 Arb 3468'

OTD 3508

DD for SWD

Granite 3884

TD 3908

PB 3655

7" @ 3624

test 121 bwph

3000 acid

Comp for SWD

Completed

COMPLETED

Kansas

Chandler Pool

Map No. _____ Sec. 11 Twp. 9 R. 19WWell No. 1 Thyfault "A"

Continental etal.

Company

FIRST REPORT

Contractor


SE SW

SECTION PLAT

_____ Ft. from N. Line

330 Ft. from S. Line330 Ft. from E. Line

_____ Ft. from W. Line

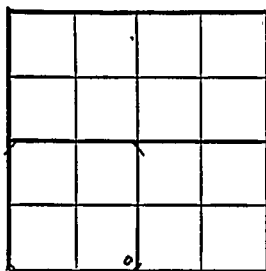

Rooks County

Location _____

Rig up _____

Drilling and Remarks:

10" @ 218 WOC

RECORD

Cased _____ in., _____ ft.

Sand _____

Gas _____

Oil _____

Total Depth _____

PRODUCTION

1st 24 hrs. Nat. _____

1st 24 hrs. after shot _____

Gas _____ Cu. Ft.

Dry Hole _____

Abandoned _____

Date

APR 27 1949

19

S. J. LEWIS

Scout

Kansas

Map No. K65 Sec. 11 Twp. 9 R. 19WWell No. 1 Thyfault "A"Continental etal. Company**ABANDONED**

Contractor

SE SW

E12031
SECTION PLAT

	0		

 Ft. from N. Line330 Ft. from S. Line330 Ft. from E. Line Ft. from W. Line

Rocks County

Location Rig up

Drilling and Remarks:

Lion 3220Dr 83468**RECORD**Cased in., ft.Sand Gas Oil Total Depth 3508**PRODUCTION**1st 24 hrs. Nat. 1st 24 hrs. after shot Gas Cu. Ft.Dry Hole Abandoned

Date

MAY 11 1949 19S. J. LEWIS Scout

Kansas

OWDD


Chandler Pool

Map No. _____ Sec. 11 Twp. 9 R. 19WWell No. 1 Thyfault_____Phillips_____
Company_____
Contractor

SE SE SW

E1. 2031
SECTION PLAT_____Ft. from N. Line330 Ft. from S. Line330 Ft. from E. Line_____Ft. from W. Line

Rooks County

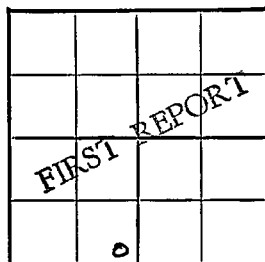

Location _____

Rig up _____

Drilling and Remarks:

Arb. 3468

TD 3508

D & A

drlg deeper @

3900 for SWD

RECORD

Cased _____ in., _____ ft.

Sand _____

Gas _____

Oil _____

Total Depth _____

PRODUCTION

1st 24 hrs. Nat. _____

1st 24 hrs. after shot _____

Gas _____ Cu. Ft.

Dry Hole _____

Abandoned _____

Date

MAR 29 19

J. E. TYRA

Scout

Map No. _____ Sec. 11 ^{Kansas} Twp. 9 R. 19W

Well No. 1 Thyfault

_____ Phillips _____ Company

_____ Contractor

SE SE SW

E1. 2031


SECTION PLAT

_____ Ft. from N. Line X

330 Ft. from S. Line

330 Ft. from E. Line

_____ Ft. from W. Line

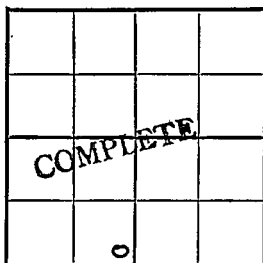

Rooks County

Location _____

Rig up _____

Drilling and Remarks:

Arb. 3468

OTD 3508

DD for SWD

Granite 3884

TD 3908

PB 3655

7" @ 3624

test 121 bwph

3000 acid

Date Comp for SWD

RECORD

Cased _____ in., _____ ft.

Sand _____

Gas _____

Oil _____

Total Depth 3908

PRODUCTION

1st 24 hrs. Nat. _____

1st 24 hrs. after shot _____

Gas _____ Cu. Ft.

Dry Hole _____

Abandoned _____

JUN 28 1950 19

J. E. TYRA Scout