


Section 11 Township 9 Range 20W


Well No. #² Baldwin

Company Jones, Shelburne & Farmer & Petr. Inc.

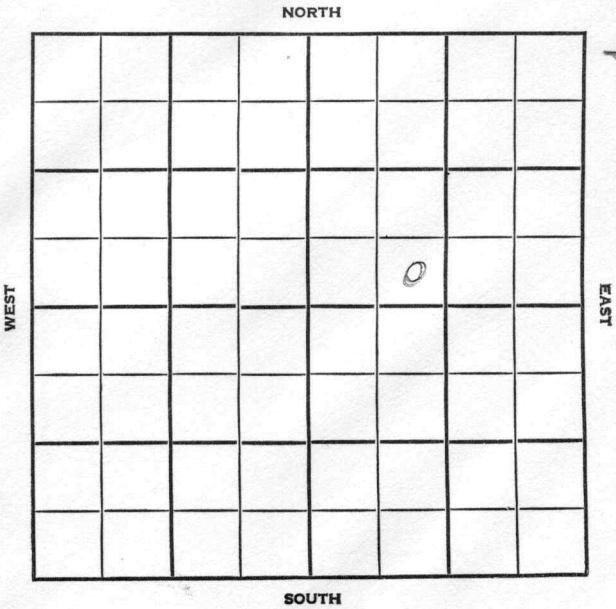

County Rooks Elev. _____
 Sec. 11 Twp. 9 Rge. 20W
 Company Jones, Shelburne & Farmer & Pet. Inc.
 Farm Name Baldwin No. 3

TOPS	DEPTH	LOG	DATUM	Loc. in Sec.
Anh.				SE SW NE
TP.				
H.				
Tr.				
Dg.				
BL.				
L.				Geol. _____
K.C.				Contr. _____
B.K.C.				Co. Tools
Ce.				
C.				Pool
M.				Cresson
M.				
K.				
Mz.				
Mq.				
V.				
S.				
S.				
A.				
R.				
PE.				
G.				
T.D.				

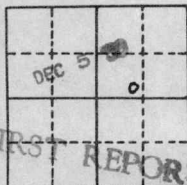

Date Comm. 12-2-56
8" @ 163 w/110, WOC

Co.

Lse.

No.

Sec.

T.

R.

CORRECTION

FORM 513 SUNRAY

County Rooks Elev. 2127
 Sec. 11 Twp. 9 Rge. 20W
 Company Jones, Shelburne & Farmer & Pet. Inc.
 Farm Name Baldwin No. 82

TOPS	DEPTH	LOG	DATUM	Loc. in Sec.
Anh.	1598			SE SW NE
Tp.				
H.	3320			
Tr.	3344			
Dg.				
BL.				
L.	3360			Geol.
N.C.				Contr.
B.K.C.				Co. Tools
Ce.				
C.				
M.				Pool
M.				Cresson
K.				
Mz.				
Mo.				
V.				
S.				
S.				
A.	3613			
R.				
PE.				
G.				
T.D.	3630			COMPLETE

Date Comm. 12-2-56
 8" @ 163 W/110, WOC DEC 12 '56 17 3545 DEC 19 '56

DST 3617-23 or 30" rec 27' Md
 688 DST 3623-30 1hr 250'
 Md y oil FPO-110 BHP 780 5 1/2
 3619/75 MICT DEC 26 '56 CO 3630
 1/2" & 5 Boph no/w 4 hrs in
 & 11 Boph no/w 8 hrs POP JAN 2 '57
 JAN 9 '57 JAN 19 '57 JAN 23 '57 Ph P. 192
 Bopd no/w gran 26'