


Section 11 Township 9 Range 21W

Well No. 3 Devaignon

Company Barnsdall Oil

Morel Pool

NORTH

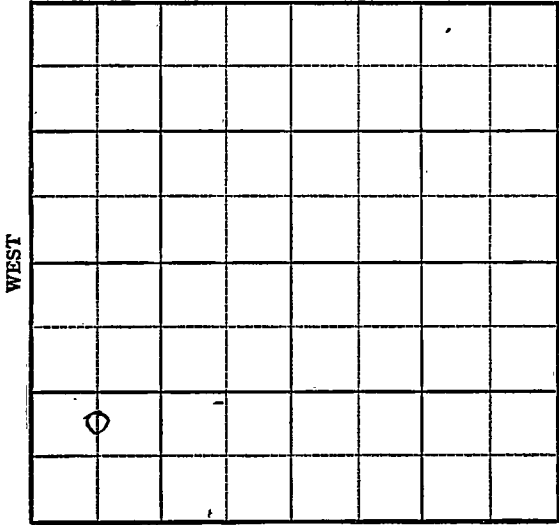

13

WEST

EAST

SOUTH

Sec. 11 Twp. 9 R. 21W ✓

Well No. 3 Devaignon Farm

Barnsdall Oil Company

Morel Pool


_____ Ft. from N. Line

990 Ft. from S. Line

_____ Ft. from E. Line

660 Ft. from W. Line

C N L SW SW

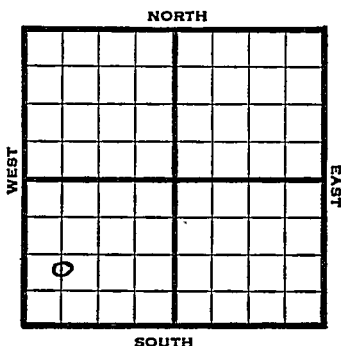

1948

Eli 2266'

R E P O R T

9/22
9/29

RUR
10" @ 290'
Drlg 2860'

10/6

Lansing 3433'
Simpson 3738'
Arb 37 49'
TD 3751'
5" @ 3749'

10/13

"

10/19

TD 3758' 500 acid
Swb 54 bbls oil 7 hrs.

10/26

"

11/3
11/10

TD 3758'
Arb. 3749'
5" @ 3749'
500 acid
Pump 197 Pot Oil
29³ Gr.

Comp

COMPLETED

Graham County Kansas State

Map No. _____ Sec. 11 Twp. 9 R. 21W

Well No. 3 Devaignon

Barnsdall Oil Company

FIRST REPORT

Contractor

C N L SW SW

SECTION PLAT

_____ Ft. from N. Line

990 Ft. from S. Line

_____ Ft. from E. Line

660 Ft. from W. Line

Morel Pool

Remarks:

R U R

Date SEP 22 1948

Scout S. J. LEWIS

Kansas

Map No. 65 Sec. 11 Twp. 9 R. 21WWell No. 3 Devaignon

Barnsdall Oil

Company

COMPLETE

Contractor

C N L SW SW

E. 2266

SECTION PLAT

 Ft. from N. Line990 Ft. from S. Line Ft. from E. Line660 Ft. from W. Line

Graham County

Location Rig up

Drilling and Remarks:

Per 37495" 3749500 acidPump 197 Peroil29th Se

RECORD

Cased in., ft.Sand Gas Oil ✓Total Depth 3758

PRODUCTION

1st 24 hrs. Nat. 1st 24 hrs. after shot Gas Cu. Ft.Dry Hole Abandoned

Date

NOV 10 1948 19

S. I. FWIS Scout