

Graham County


FORM 51 10M 8-47

KANSAS

Section 11 Township 9 Range 21W

Well No. 1 Marine Eickman

Company Hinkle & Franco Central

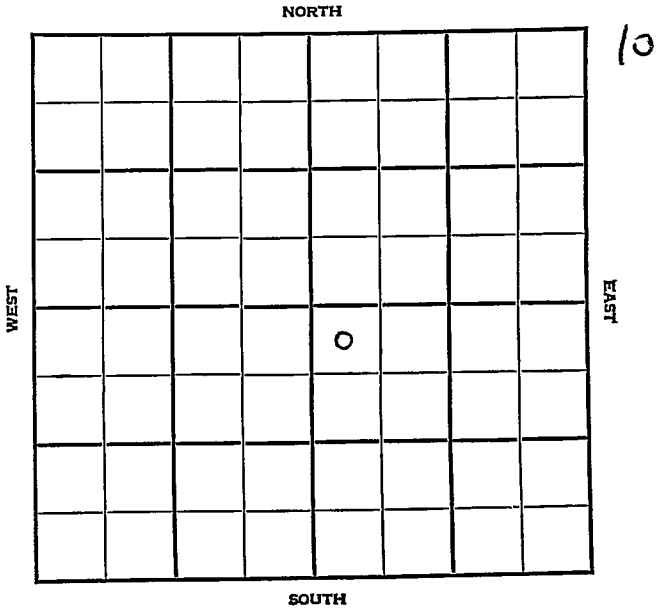

KANSAS

Graham



Sec. 11 Twp. 9 R. 21-W

Well No. #1 ~~Merino~~ Eichman Farm

Hinkle & Franco Central Company

Wildcat


330' Ft. from N. Line.

_____ Ft. from S. Line

_____ Ft. from E. Line

330' Ft. from W. Line

NW SE

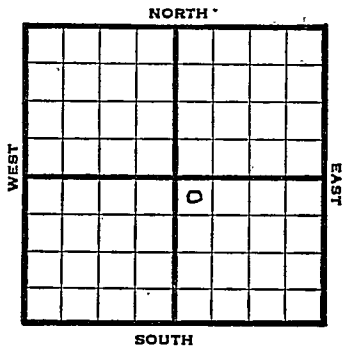

1947 Elev. 2185' REPORT

12/10 ,RUR

12/23 Lans. 3458'
Arb. 3892'
TD 3910'

ABANDONED

Map No. _____ Sec. 11 Twp. 9 R. 21W

Well No. 1 Moline

Hinkle & Franco Central Company

FIRST REPORT

Contractor

NW SE

SECTION PLAT

330 Ft. from N. Line

_____ Ft. from S. Line

_____ Ft. from E. Line

330 Ft. from W. Line

		10	

Graham County

Location _____

Rig up _____

Drilling and Remarks:

R U R

RECORD

Cased _____ in., _____ ft.

Sand _____

Gas _____

Oil _____

Total Depth _____

PRODUCTION

1st 24 hrs. Nat. _____

1st 24 hrs. after shot _____

Gas _____ Cu. Ft.

Dry Hole _____

Abandoned _____

Date

DEC 10 1947 19

S. J. LEWIS

Scout

Map No. 65 Sec. 11 Twp. 9 R. 21W

Well No. 1 Eichman

Hinkle & Franco Central Company

CORRECTION

Contractor

NW SE

SECTION PLAT

330 Ft. from N. Line

_____ Ft. from S. Line

_____ Ft. from E. Line

330 Ft. from W. Line

		o	

Graham County

Location _____

Rig up _____

Drilling and Remarks:

Reported as
#1 Morin

RECORD

Cased _____ in., _____ ft.

Sand _____

Gas _____

Oil _____

Total Depth _____

PRODUCTION

1st 24 hrs. Nat. _____

1st 24 hrs. after shot _____

Gas _____ Cu. Ft.

Dry Hole _____

Abandoned _____

Date

DEC 1 7 1947 19

S. J. LEWIS

Scout

Map No. 65 Kansas Sec. 11 Twp. 9 R. 21W

Well No. 1 Eichman

Hinkle & Franco Central Company

ABANDONED

Contractor

NW SE

E 1, 2 185
SECTION PLAT

330 Ft. from N. Line

_____ Ft. from S. Line

_____ Ft. from E. Line

330 Ft. from W. Line

		0	

Graham County

Location _____

Rig up _____

Drilling and Remarks:

Lease 3458

Per 3892

RECORD -

Cased _____ in., _____ ft.

Sand _____

Gas _____

Oil _____

Total Depth 3911

PRODUCTION

1st 24 hrs. Nat. _____

1st 24 hrs. after shot _____

Gas _____ Cu. Ft.

Dry Hole _____

Abandoned _____

Date

DEC 23 1947 19

S. J. LEWIS

Scout