


Graham

KANSAS

SECTION 11 TOWNSHIP _____ RANGE 9S 23W

WELL NO. #1 Peckham

COMPANY C & G etal

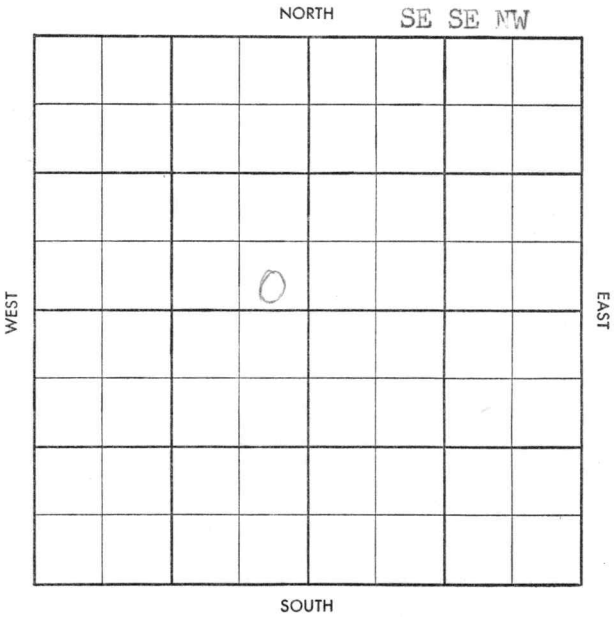

15

CO. Graham ELEV. 2317
SEC. 11 TWP. 9 RGE. 23W
COMPANY C & G etal. NO. 1

FIRST REPORT

FARM Peckham
LOC. SE SE NW

Anh.	1957

GEOL. _____
CONTR. Co. tools
POOL Mildrexter
SPUD 12-12-57
8" @ 210/160
drlg. 3075

CO.
LSE.
NO.
SEC.
TWP.
RGE.

CO. Graham ELEV. 2314 DP
2317
 SEC. 11 TWP. 9 RGE. 23W
 COMPANY. C & G et al. NO. 1

FEB 26 '58

COMPLETE

FARM. PeckhamLOC. SE SE NW

Anh. 1957
 H 3585
 TR 3608
 L 3622
 BKC 3842
 TP 3860

GEOL. _____

CONTR. Co. toolsPOOL MildrexterSPUD 12-12-57

8" @ 210/160

drlg. 3075 DEC 26 '57

pipe set

JAN 2 '58 DST 3702

-08 60" 540' SW

BHP 1335-1217/20

FPO-275 DST 3738-60

30" 8' M BHP 590/20"

DST 3764-78 90" 300

gip 30' HOC M 40' MO

BHP 1015-840 DST

3778-95 60" 240' HOC

69 M 1050 gary oi'

570' SW BHP 1038-975

Ran log 5 1/2" 3959/175 JAN 8 '58

12/ 3788-91 BHP DH XT

4/ 3781-82 SD 12/ 3775

-78 NS M 500 A \$1430

PH NW 5 hrs 1200 OB

POP

JAN 15 '58

JAN 22 '58

JAN 29 '58

FEB 5 '58 FEB 12 '58

P 568002.47

W

WDP

FEB 19 '58

FEB 26 '58

Pot

11030 PH MW

Lsg