


Graham

KANSAS

SECTION 11 TOWNSHIP _____ RANGE 9 24W

WELL NO. #1 Rice Estate

COMPANY J.E. Morris & CRA

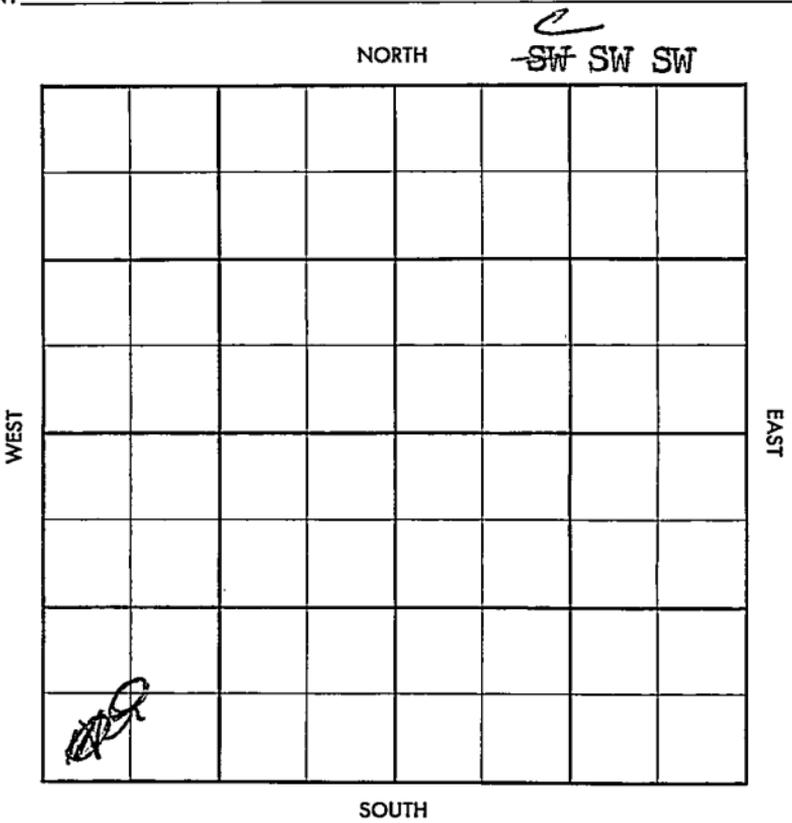

CORRECTION

Holly

FORM 513 SUNRAY

Co.

County ~~Graham~~

Elev. 2480

Sec. 11

Twp. 9

Rge. 24W

Loc.

No.

Sec.

T.

R.

Company J. E. Morris & C. R. A.

FarmName Rice Estate

No. 1

TOPS	DEPTH	LOG	DATUM	Loc. in Sec.
Anh.	2130			SW SW C
TP.				
H.	3783			
Tr.	3813			
Dg.	3823			
Bl.				
L.	3830			
K.C.				Geol.
B.K.C.	4050			Contr.
Ce.				Rex-Morris
C. <i>Marm</i>	4074			Pool
M.				Holley SE
M.				ABANDONED JUN 5 '57
K.				
Mz.				
Me.				
V.				
S.				
S.				
A.				
R.				
PE.				
G.				
T.D.	4085			0

Date Comm. Pan American - (FO)

5-26-57, 8" @ 234/130, Drig. 2100 JUN 5 '57

DST 3852-65 1hr 5' Md BHP

1174 DST 3890-3910 1hr 775'

MSW EB BHP 1317 DST

3965-90 1hr no rec BHP 0

DST 3987-4005 1hr no. 60'

50' 6CM + 30' 0' 6CM FPO-42

BHP 731/20"

DCA