


Section 12 Township 9 Range 15W

Well No. #1 Beck

Company Trans-Era & Nate Appleman

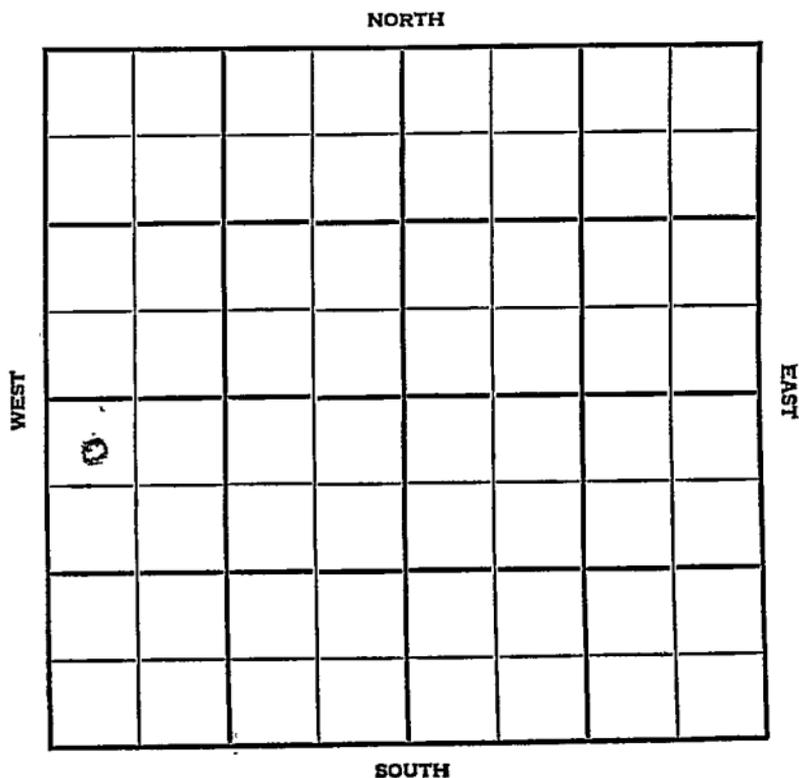

Osborne

KANSAS

SEC.

TWP.

R.

12

9

15W

WELL NO.

1 Beck

FARM

COMPANY

Trans-Era & Nate Appleman

CONTRACTOR


Wildcat

_____ Ft. from N. Line

_____ Ft. from S. Line

_____ Ft. from E. Line

_____ Ft. from W. Line

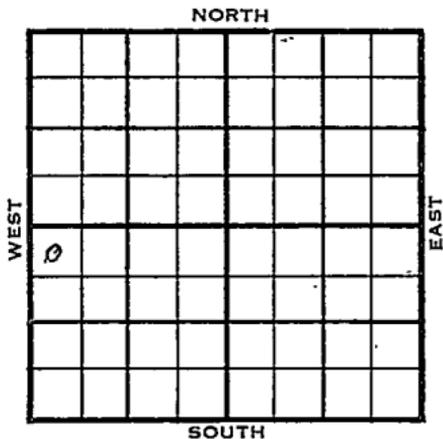

NW NW SW

ELEVATION

REPORT

1955

5/26

Comm 5-13-55
8" @ 193 w/150
Drlg 2100

6/8

Comm 5-13-55
8" @ 193/150
H 3114, Tr 3139, Bl 3159, L 3172,
BKC 3444, A 3962, TD 4010
H 3110; Tr 3134, L 3172, M Lm 3660,
V 3820, S 3908 A 3958
D & A

ABANDONED

Twp. _____ Foot _____

Co. _____ Feet _____

FORM 513 REV. SUNRAY

FIRST REPORT

County Osborne Elev. _____

Sec. 12 Twp. 9 Rge. 15W

Company Trans-Era & Nate Appleman

FarmName Beck No. 1

TOPS	DEPTH	LOG	DATUM	Loc. in Sec.																																
Anh.				NW NW SW																																
Tr.																																				
Dg.																																				
Bl.																																				
L.				Geol. _____																																
K.C.				Contr. _____																																
B.K.C.																																				
Ce.																																				
C.																																				
M.				Pool																																
K.				Wildcat																																
Mz.				<table border="1"> <tr><td></td><td></td><td></td><td></td></tr> <tr><td></td><td></td><td></td><td></td></tr> <tr><td></td><td></td><td></td><td></td></tr> <tr><td></td><td></td><td></td><td></td></tr> <tr><td></td><td></td><td></td><td></td></tr> <tr><td></td><td></td><td></td><td></td></tr> <tr><td></td><td></td><td></td><td></td></tr> <tr><td></td><td></td><td></td><td></td></tr> </table>																																
Mo.																																				
V.																																				
S.																																				
S.																																				
A.																																				
R.																																				
PE.																																				
G.																																				
T.D.																																				

Date Comm. 5-13-55

8" @ 193 w/ 150 - drlg. 2100

Co.

Lse.

No.

Sec.

T.

R.

County Osborne ✓ Elev. 1900
 Sec. 12 Twp. 9 Rge. 15W
 Company Trans-Era & Nate Appleman
 Farm Name Beck No. 1

TOPS	DEPTH	LOG	DATUM
Anh.			
Tp.			
H.	<u>3114</u>	<u>3110</u>	<u>1210</u>
Tr.	<u>3139</u>	<u>3134</u>	<u>1234</u>
Dg.			
Bl.	<u>3159</u>		<u>1259</u>
L.	<u>3172</u>	<u>3172</u>	<u>1272</u>
K.C.			
B.K.C.	<u>3444</u>		<u>1544</u>
Ce.			
C.			
M.	<u>lm</u>	<u>3660</u>	<u>1760</u>
M.			
K.			
Mz.			
Ma.			
V.		<u>3820</u>	<u>1920</u>
S.		<u>3908</u>	<u>2008</u>
S.		<u>3958</u>	<u>2058</u>
A.	<u>3962</u>	<u>3958</u>	<u>2058</u>
R.			
PE.			
G.			
TD.	<u>4010</u>		

Loc. in Sec. NW NW SW
 Geol. _____
 Contr. _____
 Pool _____
 Wildcat _____
 ABANDONED

Date Comm. 5-13-55 JUN 8 1955
8" @ 193/150

D & A

Co.
Lse.
No.
Sec.
T.
R.