


KANSAS

Section 12 Township 9 Range 17 <sup>W</sup>

Well Number 1 Baxa

Company Green Oil

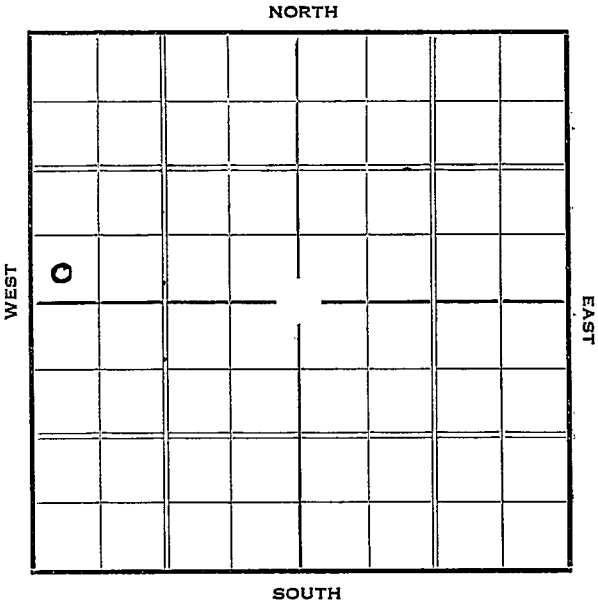

# KANSAS

## Rooks

Sec. 12 Twp. 9 R. 17-W

Well No. #1 Baxa Farm

Green Oil \_\_\_\_\_ Company

NORTH

Ft. from N. Line

330 Ft. from S. Line

Ft. from E. Line

330 Ft. from W. Line

WEST

EAST

SOUTH

19<sup>Date</sup> 38

## REPORT

|      |          |     |         |
|------|----------|-----|---------|
| 12/2 | Location | 5/7 | RU & SD |
|------|----------|-----|---------|

|                |              |
|----------------|--------------|
| 12/10--12/17-- | 5/14 Mov. in |
| 12/24          | tools.       |

|       |        |
|-------|--------|
| 12/24 | Cellar |
|-------|--------|

|       |        |
|-------|--------|
| 12/29 | Ponds. |
|-------|--------|

1937

|     |      |
|-----|------|
| 1/7 | Rig. |
|-----|------|

|      |                |
|------|----------------|
| 1/14 | Dig water well |
|------|----------------|

|      |    |    |    |
|------|----|----|----|
| 1/21 | re | re | re |
|------|----|----|----|

|      |      |
|------|------|
| 1/28 | Rig. |
|------|------|

|      |   |
|------|---|
| 2/11 | π |
|------|---|

|      |   |
|------|---|
| 2/19 | " |
|------|---|

2/26 11

|     |             |
|-----|-------------|
| 3/4 | Rigging up. |
|-----|-------------|

|      |           |
|------|-----------|
| 3/11 | Shut Down |
|------|-----------|

|      |    |    |
|------|----|----|
| 3/18 | 11 | 11 |
|------|----|----|

3/25 11 11

|     |    |    |
|-----|----|----|
| 4/2 | 11 | 11 |
|-----|----|----|

|     |    |   |
|-----|----|---|
| 4/8 | 11 | 1 |
|-----|----|---|

4/16 | " |

|      |         |
|------|---------|
| 4/23 | RU & SD |
|------|---------|

4/30 | 11 11

**OVER**

1937

5/21 20" @ 110'.  
WOC.

5/28 Drlg. 2105'.

6/4 Topeka 2895'.

Drlg. 2970'.

6/11 8" @ 3165'. WOC.

6/19 " " "

6/25 Osw. 3146'. T.D. 3215'.

S.O. 3210-15'.

Swab 40 bbls. per hr.

7/2 T.D. 3255'. 2600' oil in 12  
hrs. Bldg. tanks.

7/9 6000 acid. Pump 624 bbls. 19  
hrs.

7/16 Taking potential.

7/21 Oswald 3146'  
8" @ 3165'  
TD 3255'  
6000 acid  
Pumped 790/18 hrs  
Pot 1110

COMPLETED

KANSAS

Map No. 64 Sec. 12 Twp. 9 R. 17WWell No. 1 Box AGreen Oil Company

Contractor

## SECTION PLAT

|   |  |  |  |
|---|--|--|--|
|   |  |  |  |
|   |  |  |  |
| 0 |  |  |  |
|   |  |  |  |

       Ft. from N. Line330 Ft. from S. Line       Ft. from E. Line330 Ft. from W. Line

## FIRST REPORT

Location ✓Rig up       

Drilling and Remarks:

## RECORD

Cased        in.,        ft.Sand       Gas       Oil       Total Depth       

## PRODUCTION

1st 24 hrs. Nat.       1st 24 hrs. after shot       Gas        Cu. Ft.Dry Hole       Abandoned       

Date

DEC 2 1936 19

S. J. LEWIS Scout

*Rooks*Map No. *64* Sec. *12* Twp. *9* R. *17<sup>W</sup>*Well No. *1 - Baxa**Green Oil* Company

Contractor

**COMPLETED****SECTION PLAT**

|   |  |  |  |
|---|--|--|--|
|   |  |  |  |
|   |  |  |  |
| 0 |  |  |  |
|   |  |  |  |
|   |  |  |  |

\_\_\_\_\_ Ft. from N. Line

*330* Ft. from S. Line

\_\_\_\_\_ Ft. from E. Line

*330* Ft. from W. Line

Location \_\_\_\_\_

Rig up \_\_\_\_\_

Drilling and Remarks:

*6000 Acid**Pumped 790/18 hrs**POT - 1110***RECORD**Cased *8* in., *3165* ft.Sand *Oswald* *3146*

Gas \_\_\_\_\_

Oil \_\_\_\_\_

Total Depth *3255***PRODUCTION**

1st 24 hrs. Nat. \_\_\_\_\_

1st 24 hrs. after shot \_\_\_\_\_

Gas \_\_\_\_\_ Cu. Ft.

Dry Hole \_\_\_\_\_

Abandoned \_\_\_\_\_

Date

*JUL 21 1937* 19*H. D. Hatfield*

Scout