Form 51-5M-12-36 Com'l


KANSAS

Rooks

Section 12 Township 9 Range 17-W

Well Number #2 Baxa

Company J.H. Leavell

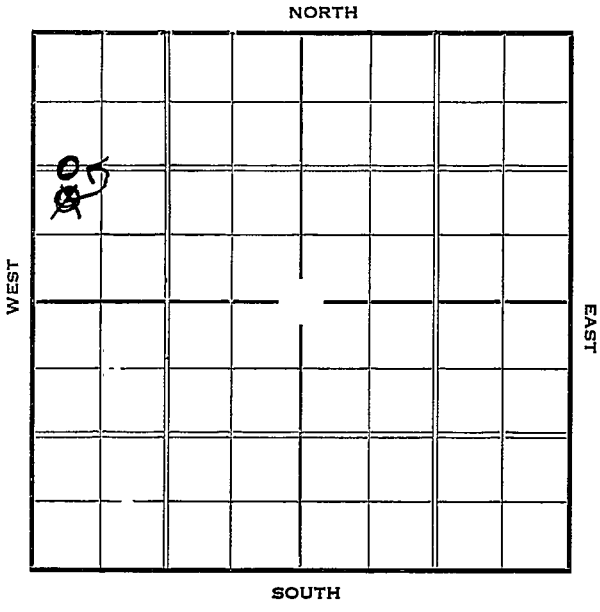

O. W. D. D.

Form 252-A—5M—2-37—Palace KANSAS Rooks

Sec. 12 Twp. 9 R. 17-W

Well No. #2 Baxa Farm


J.H. Leavell Company

1320 Ft. from N. Line

~~990~~ Ft. from S. Line

Ft. from E. Line

~~330~~ 330 Ft. from W. Line

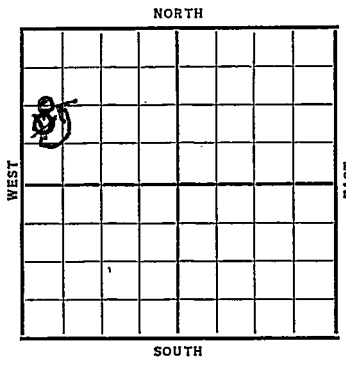

Elev. 2023

Date	REPORT O.W.D.D.
1937	
6/30	Location
7/9	"
7/16	R O G
7/23	R. U.
7/30	12" @ 116'. Drlg. 1560'.
8/6	Topeka 2865'. Drlg. 2995'.
8/13	K.C. 3160'. 8" @ 3190'.
	T.D. 3195'. RUST.
8/20	T.D. 3255' C.O.
8/28	K.C. 3143' (Corrected)
	At 3255' swab 3 bbls. oil 8
	hrs. S.O. 3283-90 & 3317-20'.
	Swabbing 3 bbls. oil per hour.
	Drlg. 3340'.
9/3	T.D. 3355'. 6000 acid.
9/10	Swabbing 20 bbls. oil per hour.

EP

OVER

1937
9/15 8" @ 3190'
K.C. 3143' (corrected)
TD 3355'
6000 acid
Pot 794

COMPLETED

1938 O. W. D. D.

2/9 Old T.D. 3355'.
Arb. 3447'.
S.O. 3448-50 & 3454-59'.
7" @ 3450'.
T.D. 3473'.
2000 acid.
Pump 30 bbls. fluid per hour.
20% water.
P.B. to 3350'.
Completed for old Potential of
794 bbls.

FIRST REPORT
and
COMPLETED

Form 26—1M Bks.—2-29

Rooks KANSAS

Map No. 64 Sec. 12 Twp. 9 R. 17 W


Well No. 2 Baka

J. H. Leavell Company

Contractor

FIRST REPORT

SECTION PLAT

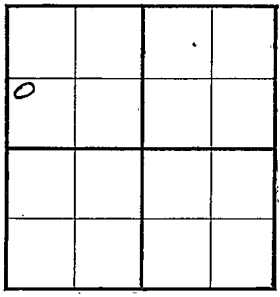

Ft. from N. Line

990 Ft. from S. Line

Ft. from E. Line

330 Ft. from W. Line

Location ✓

Rig up

Drilling and Remarks:

62

RECORD

Cased in., ft.

Sand

Gas

Oil

Total Depth

PRODUCTION

1st 24 hrs. Nat.

1st 24 hrs. after shot

Gas Cu. Ft.

Dry Hole

Abandoned

Date

JUN 30 1937 19

H. D. Hatfield Scout

Form 26—1M Bks.—2-29 Rooks KANSAS

Map No. 64 Sec. 12 Twp. 9 R. 17W


Well No. 2- Baker

J. H Leavell Company

Contractor

COMPLETED

SECTION PLAT

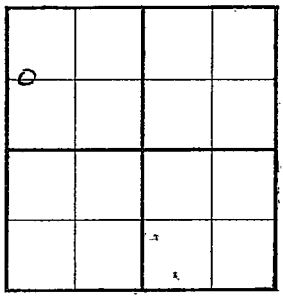

_____ Ft. from N. Line

990 Ft. from S. Line

_____ Ft. from E. Line

330 Ft. from W. Line

Location _____

Rig up _____

Drilling and Remarks:

6000 acid

Pot. 794

RECORD

Cased 8 in., 3190 ft.

Sand KC. 3143

Gas (corrected)

Oil _____

Total Depth 3355

PRODUCTION

1st 24 hrs. Nat. _____

1st 24 hrs. after shot _____

Gas _____ Cu. Ft.

Dry Hole _____

Abandoned _____

Date

SEP 15 1937 19 _____

H. D. Hatfield Scout

Form 26—1M Bks.—2-29 Rooks KANSAS

Map No. 64 Sec. 12 Twp. 9 R. 17W

Well No. 2 Baxa

Leavell Company

CORRECTION Feet

~~FIRST REPORT~~ Measure- Contractor

~~COMPLETED~~ Ments SECTION PLAT


C W L NW

1320 Ft. from N. Line

_____ Ft. from S. Line

_____ Ft. from E. Line

330 Ft. from W. Line

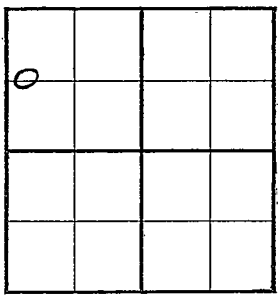

Location _____

Rig up _____

Drilling and Remarks:

OWDD-OTD. 3355

Arb 3447

S.O. 3448-50 & 3454-59

7" 3450

T.D. 3473

2000 Acid Pump 30 bbls

Fluid P.H. 2070 wtr.

P.B. 3350 Completed

For old P.O. of 794

RECORD

Cased _____ in., _____ ft.

Sand _____

Gas _____

Oil _____

Total Depth _____

PRODUCTION

1st 24 hrs. Nat. _____

1st 24 hrs. after shot _____

Gas _____ Cu. Ft.

Dry Hole _____

Abandoned _____

Date

FEB 9 1938 19 H. D. Hatfield Scout