


Section 12 Township 9 Range 17-W


Well No. 3 - Baxa

Company J. H. Leavell

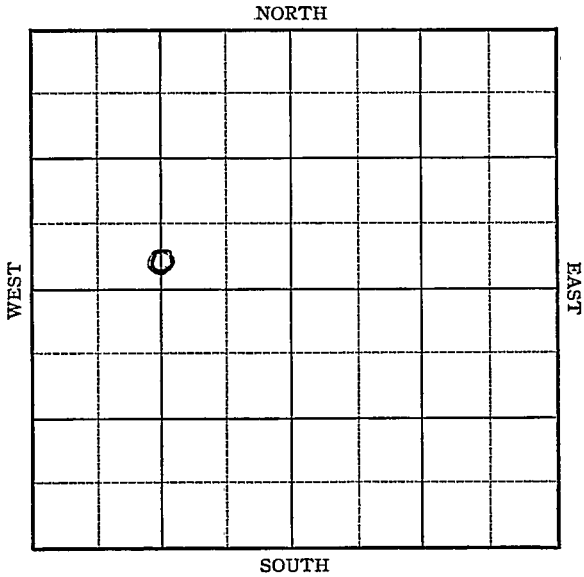

Sec. 12 Twp. 9 R. 17-WWell No. #3 Baxa FarmJ.H. Leavell Company Ft. from N. Line330 Ft. from S. Line Ft. from E. Line1320 Ft. from W. Line

Elev. 2012

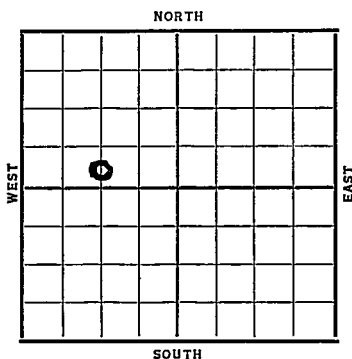

Date	REPORT
1937	
8/4	B.R.R.
8/13	S. H.
8/20	15" @ 94'. Drlg. 1800'.
8/28	Anhy 1285'. Topeka 2890'.
	Drlg. 2970'.
9/3	8"7' @ 3168'. T.D. 3177'.
9/10	K.C. 3155'. RUST.
9/17	" " " "
9/24	7" @ 3168' (Corrected)
	T.D. 3240'. 600' oil. Swab.
10/2	T.D. 3240'. 5000 acid.
10/6	7" @ 3168' (Corrected)
	K.C. 3155'.
	T.D. 3240'.
	5000 acid.
	Pot. 882 bbls.
	COMPLETED

Rooks KANSASMap No. 64 Sec. 12 Twp. 9 R. 17 WWell No. 5 - BataJ. H. Leavell Company

Contractor

FIRST REPORT

SECTION PLAT

_____ Ft. from N. Line

330 Ft. from S. Line

_____ Ft. from E. Line

1320 Ft. from W. Line

Location _____

Rig up _____

Drilling and Remarks:

B.R.R.

RECORD

Cased _____ in., _____ ft.

Sand _____

Gas _____

Oil _____

Total Depth _____

PRODUCTION

1st 24 hrs. Nat. _____

1st 24 hrs. after shot _____

Gas _____ Cu. Ft.

Dry Hole _____

Abandoned _____

Date

AUG 4 - 1937 19 H. D. Hatfield Scout

Rooks KANSAS

Map No. 64 Sec. 12 Twp. 9 R. 17WWell No. 3 BazaJohn Leavell Company

Contractor

COMPLETED

C S L NW

 Ft. from N. Line330 Ft. from S. Line Ft. from E. Line1320 Ft. from W. Line

SECTION PLAT

	0		

Location _____

Rig up _____

Drilling and Remarks:

5000 AcidPOT-882RECORD *(Corrected)*Cased 7 in., 3168 ft.Sand A.C. 3155

Gas _____

Oil _____

Total Depth 3240

PRODUCTION

1st 24 hrs. Nat. _____

1st 24 hrs. after shot _____

Gas _____ Cu. Ft.

Dry Hole _____

Abandoned _____

Date

OCT - 6 1937H. D. Hatfield

19

Scout