

Company Gabbert

EAST

SOUTH

KANSAS

Rooks

Sec. 12 Twp. 9 R. 17W ✓

Well No. #1 Harbe Farm

Gabbert

Company

Westhusin Pool


990' Ft. from N. Line

Ft. from S. Line

Ft. from E. Line

330' Ft. from W. Line

SW NW NE

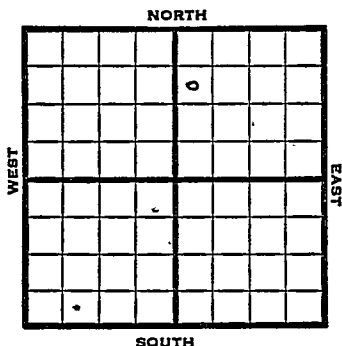

1948	Elev 1987'	REPORT
12/15	8" @ 192'	Anhy. 1265'
12/22	Drlg. 2961'	Lansing 3107'
	BKC 3356	Arb. 3417'
	TD 3420	5" @ 3419'
12/29	"	
1/5	"	
1/12	"	
1/19	"	
1/26	"	
2/2	"	
2/9	Lansing 3107'	BKC 3356'
	Arbuckle 3417'	TD 3420'
	5 @ 3419'	
2/16	24 shots 3314-18	3000 acid
	Pump 31 bbls fluid PH 5 hrs.	40% W
2/23	"	
3/2	"	
3/8	"	
3/16	"	
3/23	"	
3/30	"	

OVER

1949

4/6

24 shots 3314-18

3000 acid

Pump 31 bbls fluid PH 5 hrs.

40% W

4/12

"

4/20

"

4/27

"

5/4

TD 3420'

Lans. 3107'

Arb. 3417'

5" @ 3419'

Perf Lans.

3000 acid

Pump 20 Oil / 50% W Pot

27° Gr.

Comp

COMPLETED

Map No. _____ Sec. 12 Twp. 9 R. 17W

Well No. 1 Harbe

Gabbert Company

FIRST REPORT

Contractor

SW NW NE


SECTION PLAT

990 Ft. from N. Line

_____ Ft. from S. Line

_____ Ft. from E. Line

330 Ft. from W. Line

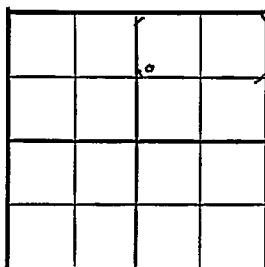

Rooks County

Location _____

Rig up _____

Drilling and Remarks:

8" @ 192

Anhy 1265

drlg. 2961

RECORD

Cased _____ in., _____ ft.

Sand _____

Gas _____

Oil _____

Total Depth _____

PRODUCTION

1st 24 hrs. Nat. _____

1st 24 hrs. after shot _____

Gas _____ Cu. Ft.

Dry Hole _____

Abandoned _____

Date

DEC 15 1948 19

S. J. LEWIS

Scout

Kansas

Map No. K-64 Sec. 12 Twp. 9 R. 17WWell No. 1 HrabeGabbert Company**COMPLETE**

Contractor

SW NW NE

E1, 1987
SECTION PLAT990 Ft. from N. Line Ft. from S. Line Ft. from E. Line330 Ft. from W. Line

		o	

Rooks County

RECORDLocation Cased in., ft.Rig up Sand

Drilling and Remarks:

Gas Oil Total Depth 3421**PRODUCTION**1st 24 hrs. Nat. 1st 24 hrs. after shot Gas Cu. Ft.Dry Hole Abandoned

Date

Scout

MAY 4 1949 19

S. J. LEWIS

Lane 310?Ar 34175" @ 3418Perf Lane3000 acidPump 20 oil @ 150% SWPost25-8-49