

O. W. P. B.


KANSAS Rooks

Section 12 Township 9 Range 17W

Well No. #3 McClary
~~3 McGary~~

Company Atlantic Ref.

Westhusin Pool
NORTH

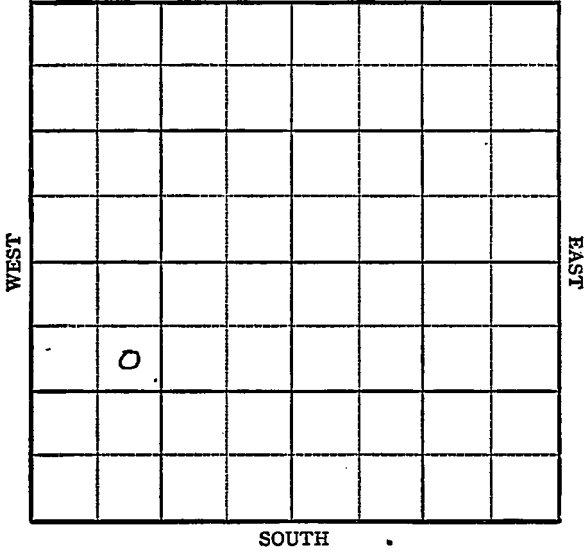

O. W. P. B.

KANSAS Rooks

Sec. 12 Twp. 9 R. 17-W ✓Well No. #3 McClay Farm

Atlantic Refg.

Company

Westhusin Pool 4


990 Ft. from N. Line

Ft. from S. Line

Ft. from E. Line

990 Ft. from W. Line

SE NW SW

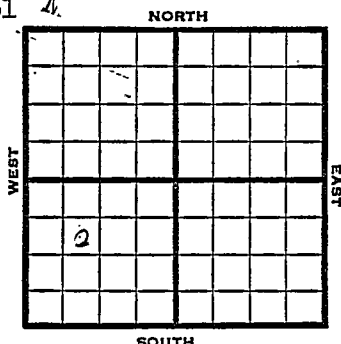

1948

Eli 2030'

REPORT

10/6

Surface Hole

10/13

10" @ 179'

Drlg 2000'

10/19

Lansing 3158'

Drlg 332 6'

10/26

Arb. 3431

5" @ 3432

TD 3434 1000' oil

11/3

500 acid

Swb 12 fluid PH - 24 hrs.

11/10

Pump 222 bbls fluid 24 hrs, 15% W

11/16

"

11/23

"

11/30

"

12/8

TD 3434'

Arb. 3431'

5" @ 3432'

500 acid

Pump 151 Oil / 42% W Pot

37 Gr.

Comp

1952

4/23

COMPLETED
O. W. P. B.

Oil well TD 3433' Lans. 3153'

Arb. 3431' OTD 3433' 5" @ 3432'

35/3339-44 35/3330-35 50/3312-21

54/3250-58 30/3243-47 B/1 GO 1 GWPH

10,500 A P/9 BOPH 25% water.

Comp. 200 BOPD 20% water.

FIRST REPORT**COMPLETED**

Map No. _____ Sec. 12 Twp. 9 R. 17WWell No. 3 McCryAtlantic

Company

FIRST REPORT

Contractor

SE NW SW

SECTION PLAT

990 Ft. from N. Line Ft. from S. Line Ft. from E. Line990 Ft. from W. Line

Rooks County

Location _____

Rig up _____

Drilling and Remarks:

surface hole

RECORD

Cased _____ in., _____ ft.

Sand _____

Gas _____

Oil _____

Total Depth _____

PRODUCTION

1st 24 hrs. Nat. _____

1st 24 hrs. after shot _____

Gas _____ Cu. Ft.

Dry Hole _____

Abandoned _____

Date

OCT 6 1948 19S. J. LEWIS Scout

Map No. 64 Sec. 12 Twp. 9 R. 17W

Well No. 3 McCry

Atlantic Company

COMPLETE Contractor

SE NW SW

E. 2030
SECTION PLAT

990 Ft. from N. Line

 Ft. from S. Line

 Ft. from E. Line

990 Ft. from W. Line

Rooks County

Location

Rig up

Drilling and Remarks:

CR 43481
5-103482
5000000
Pump 151 oil + 42%
W.B.T.
87%

RECORD

Cased in., ft.

Sand

Gas

Oil *1*

Total Depth *3484*

PRODUCTION

1st 24 hrs. Nat.

1st 24 hrs. after shot

Gas Cu. Ft.

Dry Hole

Abandoned

Date

DEC 8 1948 19 S. J. LEWIS Scout

O. W. P. B.

County Rooks State Kansas
 Sec. 12 (Blk. 19) (Sur. Rge.) 17W Map No. 9
 Operator Atlantic Ref.
 Well No. 3 Farm McClay
 Elev. _____ Location SE NW SW

FIRST REPORT

COMPLETE

990 Ft. From N Line SW
 990 Ft. From W Line Quarter
 Ist. Report APR 23 1952
 Completion APR 23 1952
 Remarks (OWPB)

O. W. P. B.

Spudding Date _____

Drlg. Data Oil well TD 3433Lans. 3153 Arb. 3431 OTD 34335" @3432 35/ 3339-44 35/ 3330-3550/ 3312-21 54/ 3250-58 30/ 3243-47B/ 1 go 1 gwph 10500 A P/ 9 boph25% water Comp. 200 bopd 20% water

J. G. McGEHEE