

Section 12 Township 9 Range 17W

Well No. 4 McClay

Company C R A

Westhusin

NORTH

WEST

EAST

0							

SOUTH

KANSAS Rooks

Sec. 12 Twp. 9 R. 17W

Well No. #4 McClay Farm

C R A

Company


Westhusin Pool

 Ft. from N. Line

990' Ft. from S. Line

 Ft. from E. Line

330' Ft. from W. Line

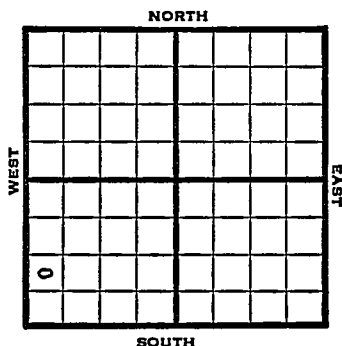

NW SW SW

1949 Elev. 2038' REPORT

5/4 Location
5/10 8" @ 206'
Drlg 2650'
5/18 Lans 3161'
Arb. 3440-43'
TD 3443'
5" @ 3440'
5/25 TD 3446'
500 acid
Pump 150 bbls oil 8 hrs.
6/1 "
6/8 "
6/15 "
6/21 "
6/28 "
7/6 Arb 3440'
5" @ 3440'
Acid 500
Pump 150 oil Pot.
Gr. 27°
TD 3446'
COMPLETED

Map No. _____ Sec. 12 Twp. 9 R. 17W

Well No. 4 McClay

C R A Company

FIRST REPORT

Contractor

NW SW SW

SECTION PLAT

o			

_____ Ft. from N. Line

990 Ft. from S. Line

_____ Ft. from E. Line

330 Ft. from W. Line

Rooks County

Location X

Rig up _____

Drilling and Remarks:

RECORD

Cased _____ in., _____ ft.

Sand _____

Gas _____

Oil _____

Total Depth _____

PRODUCTION

1st 24 hrs. Nat. _____

1st 24 hrs. after shot _____

Gas _____ Cu. Ft.

Dry Hole _____

Abandoned _____

Date

MAY 4 1949

S. J. LEWIS Scout

Map No. K64 Sec. 12 Twp. 9 R. 17W

Well No. 4 McClay

C R A Company

COMPLETE

Contractor

NW SW SW

E 12038
 SECTION PLAT

o			

 Ft. from N. Line

990 Ft. from S. Line

 Ft. from E. Line

330 Ft. from W. Line

Rooks County

Location

Rig up

Drilling and Remarks:

Cr 23440
5" @ 3440
500 acud
Prod 150 oil bbl.
279 ft

RECORD

Cased in., ft.

Sand

Gas

Oil

Total Depth 2446

PRODUCTION

1st 24 hrs. Nat.

1st 24 hrs. after shot

Gas Cu. Ft.

Dry Hole

Abandoned

Date

JUL 6 1949 19

S. J. LEWIS

Scout